


T.31S., R.41E., W.M.

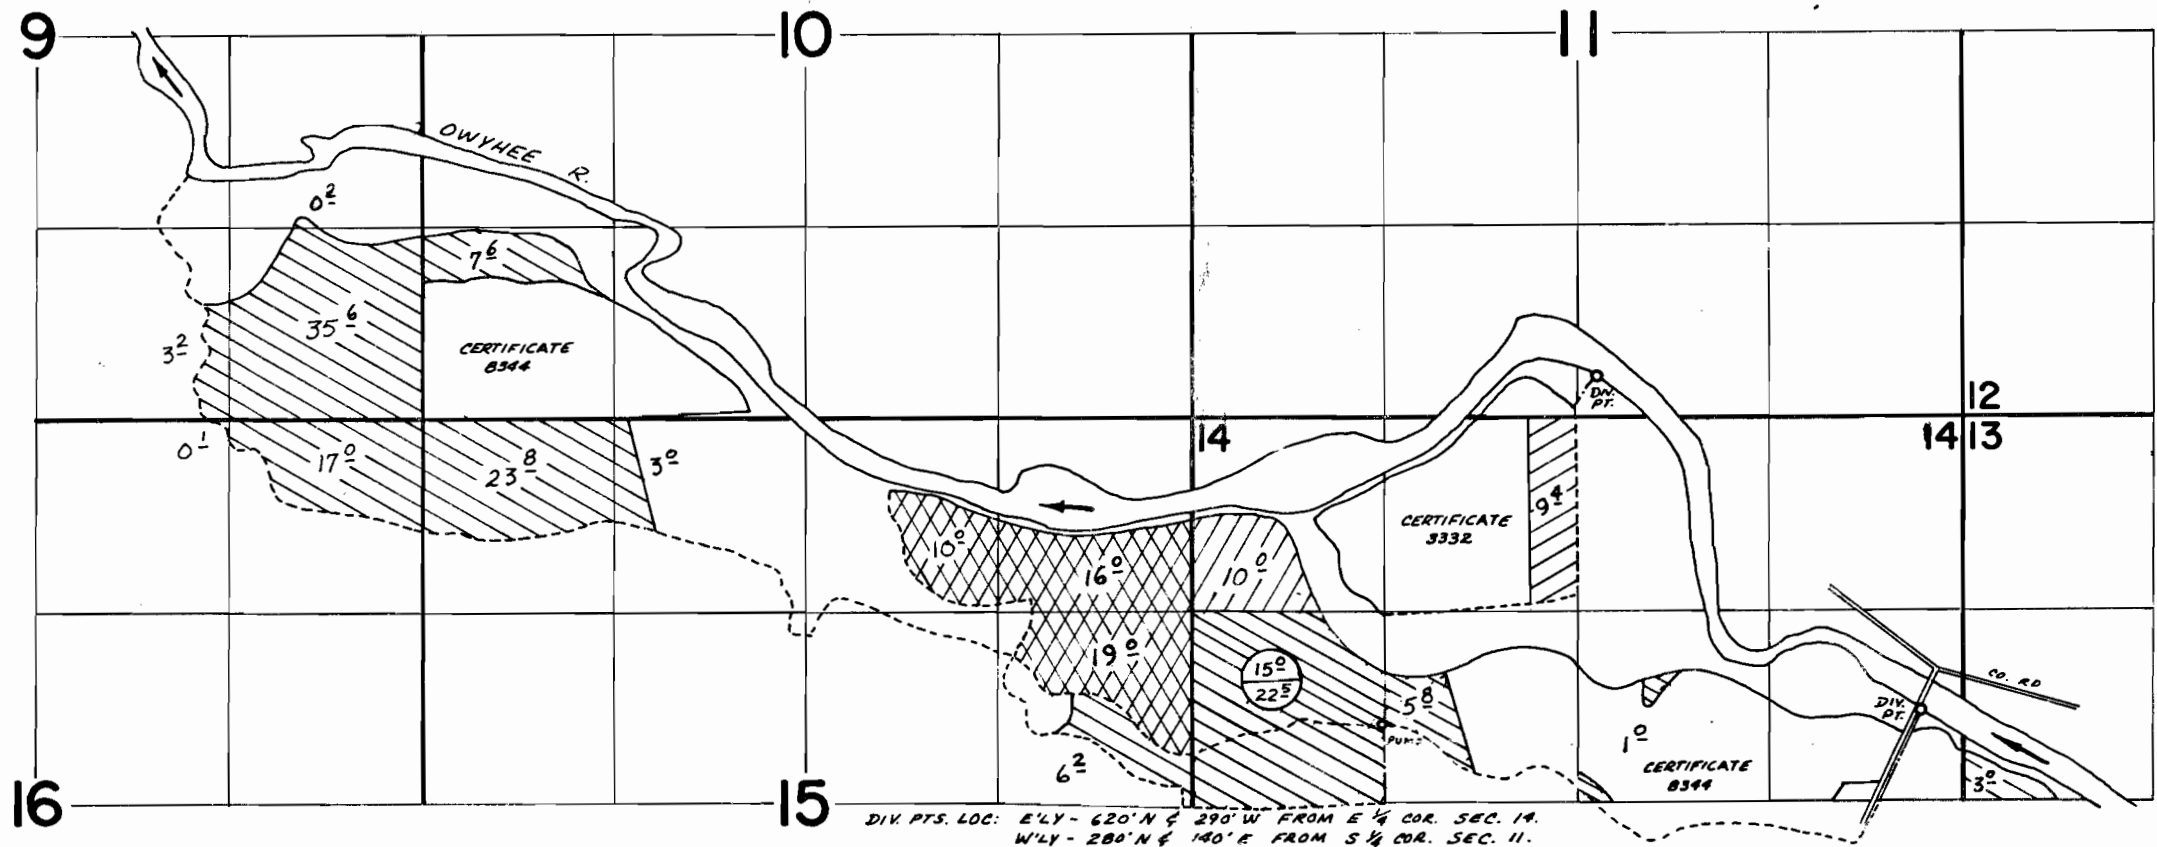

APP-43311
APP-43312
APP-43313

OLD RIGHT
PERMIT 36109

FINAL PROOF SURVEY UNDER

Application No. 43311 Permit No. 36107
43312 36108
43313 36109

Transfer No. D-124
IN NAME OF

ROBERT DOWELL

Surveyed: July 14, 1975, by: D. Norby