


T.31S., R.41&42E., W.M.

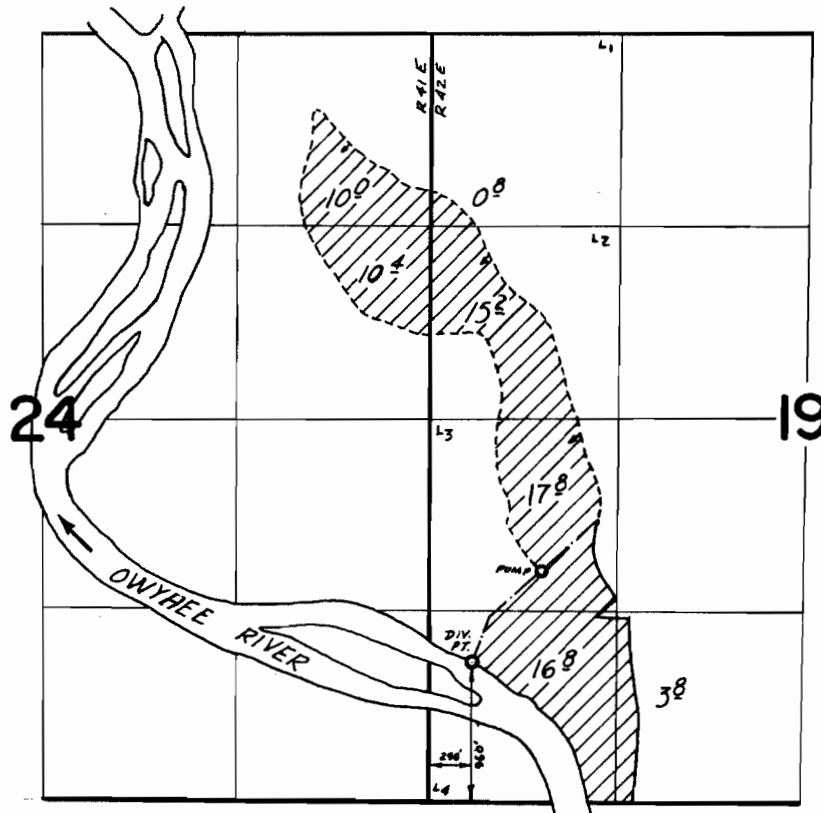

FINAL PROOF SURVEY
UNDER

Application No. 43315 Permit No. 31700
IN NAME OF
ARELGOLD, INC.

Surveyed July 14 1975, by D. Norby