


# T. 6S. R. 3W. W.M.

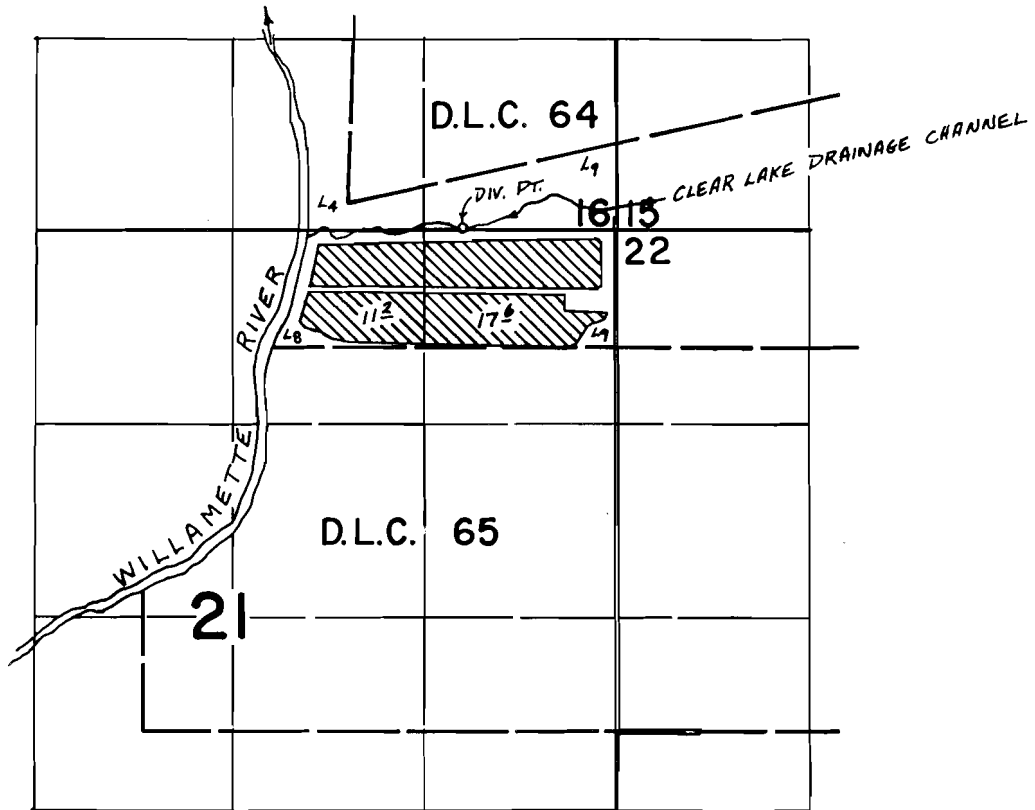

DIV. PT. LOC.: 10' N. & 1150' W. FROM NE COR. SEC. 21

## FINAL PROOF SURVEY UNDER

Application No. 43802 Permit No. 32751  
IN NAME OF

R. C. PARSONS & SON

Surveyed MAY 29 1975, by L. H. NUNN