


T.9S. R.3W. W.M.

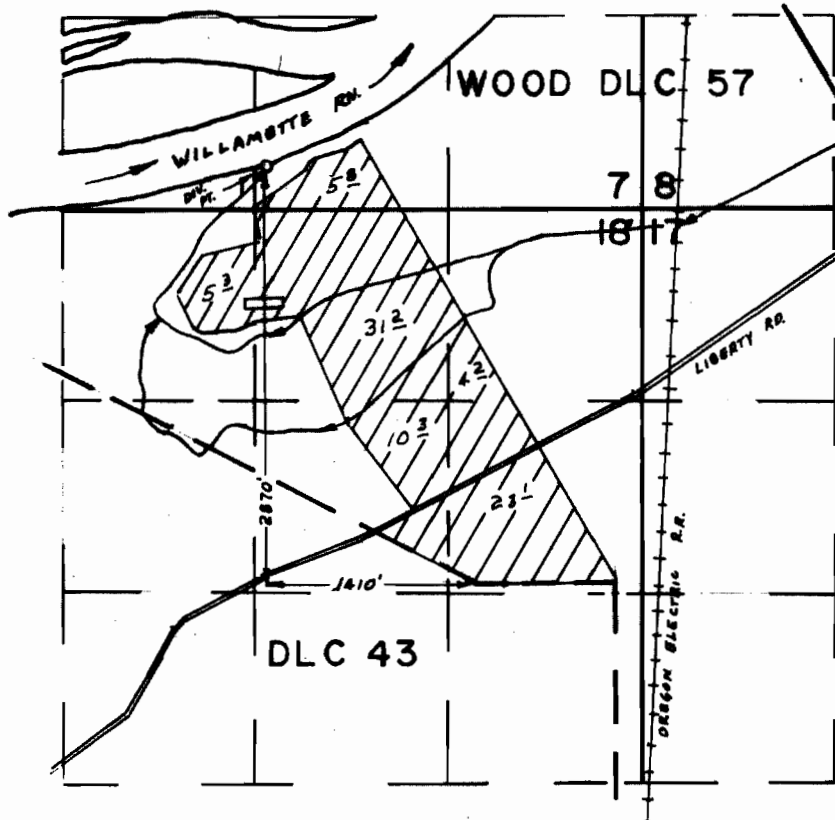

FINAL PROOF SURVEY UNDER

.....
DONNA MAE JENSEN

Application No. 47022.. Permit No. 34879
IN NAME OF

.....
Surveyed JUL 5 1974, by L.H.NUNN.....