


T.6S.,R.1W.,W.M.

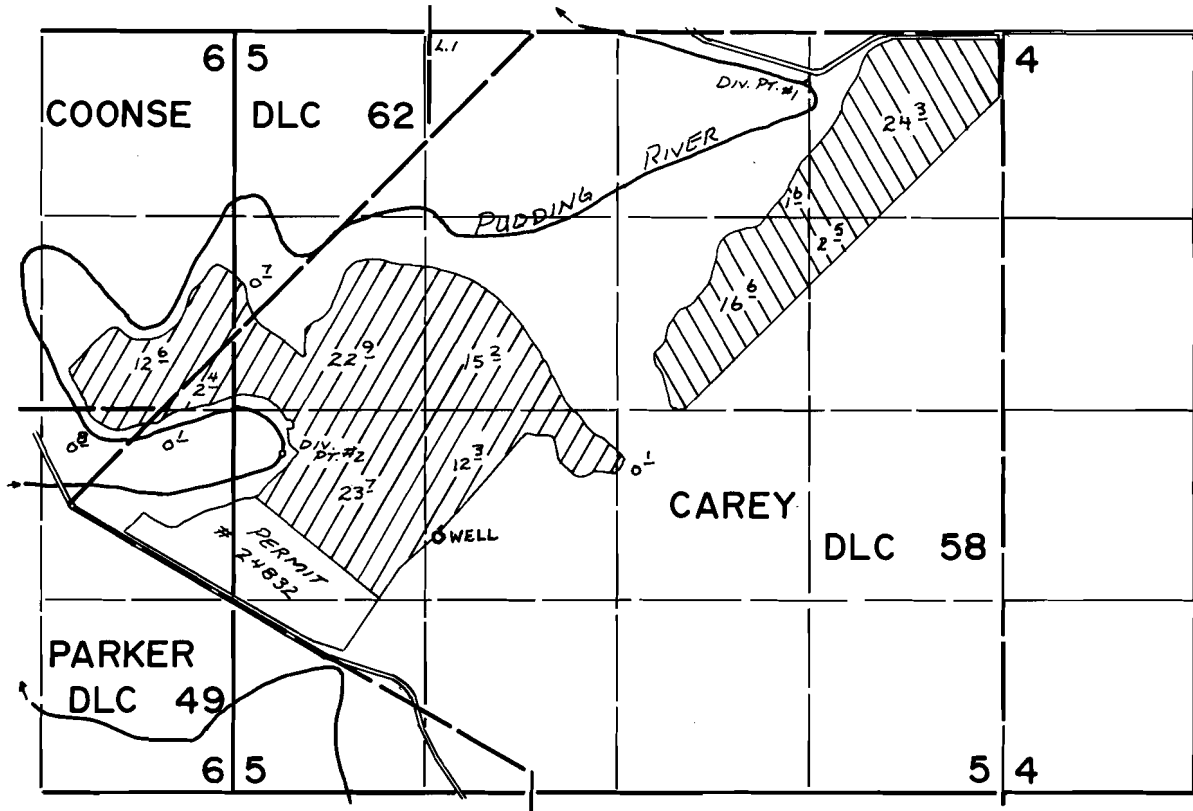

DIV. PT. #1: 350'S AND 1340' W FROM NE COR. SEC. 5
 DIV. PT. #2: 300'S AND 340' E FROM W 1/4 COR. SEC. 5
 WELL: 875'S AND 1400'E FROM W 1/4 COR. SEC. 5

FINAL PROOF SURVEY

UNDER

Transfer 3169

24832

G-7349

G-6808

50225

37880

Application No. 52695 Permit No. 38223

IN NAME OF

THOMAS P. & EVANELLE E. EWING

Sept. 6 1977 D. NORBY

Surveyed Aug. 10. 1976, by L. TOLL

