


T.10S.,R.5W.,W.M.

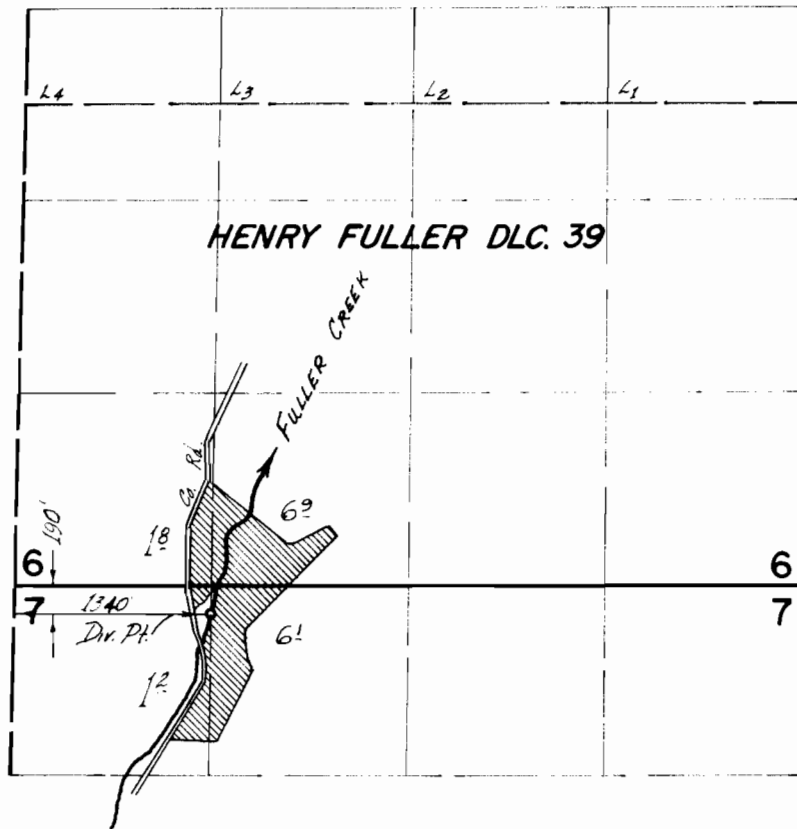

**FINAL PROOF SURVEY**  
UNDER

Application No. 41151 Permit No. 30678  
IN NAME OF

JACK AND PENELOPE JOYCE

Surveyed Sept. 27, 1973, by S. Applegate