


T.6S.,R.6W.,W.M.

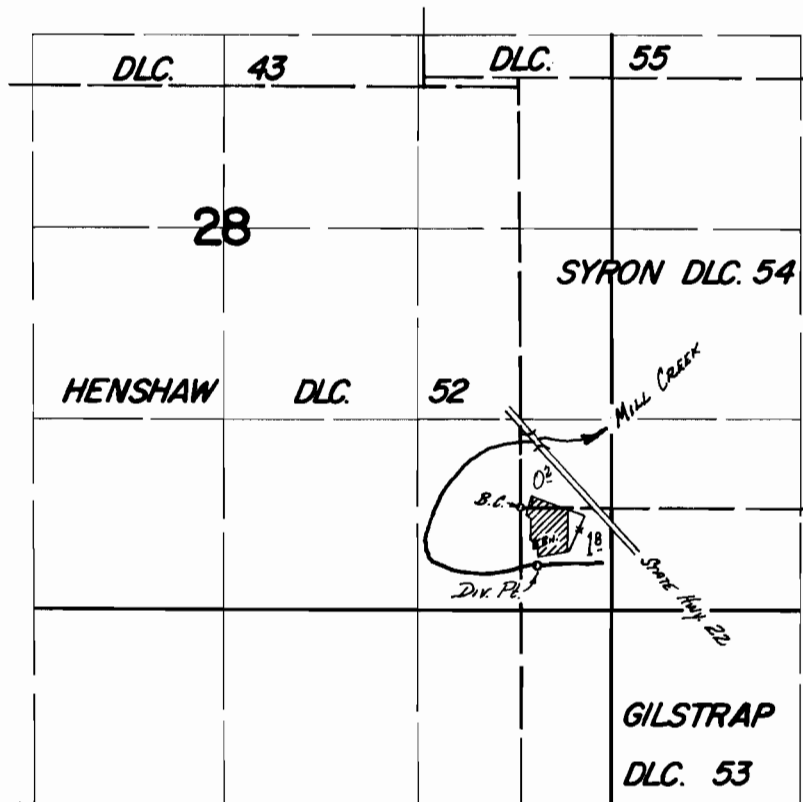

Dix. Pt. loc.: 400' S. & 120' E. FROM NW COR. GILSTRAP DLC. 53.

FINAL PROOF SURVEY
UNDER

Transfer No. 2614

Application No. Permit No.

IN NAME OF

CHARLES H. JONES

Surveyed *May 8* 19*73*, by *D. Noesly*