
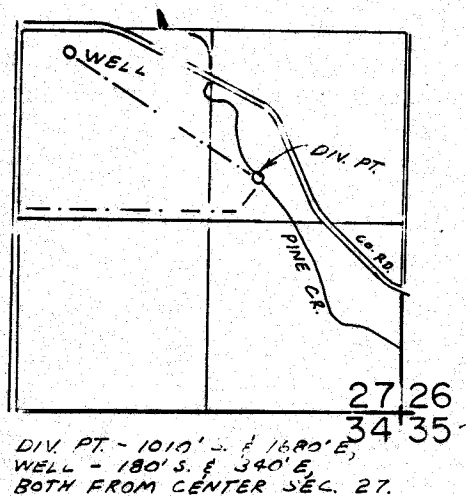


G-4515

44326

T.4N. R.35E. W.M.

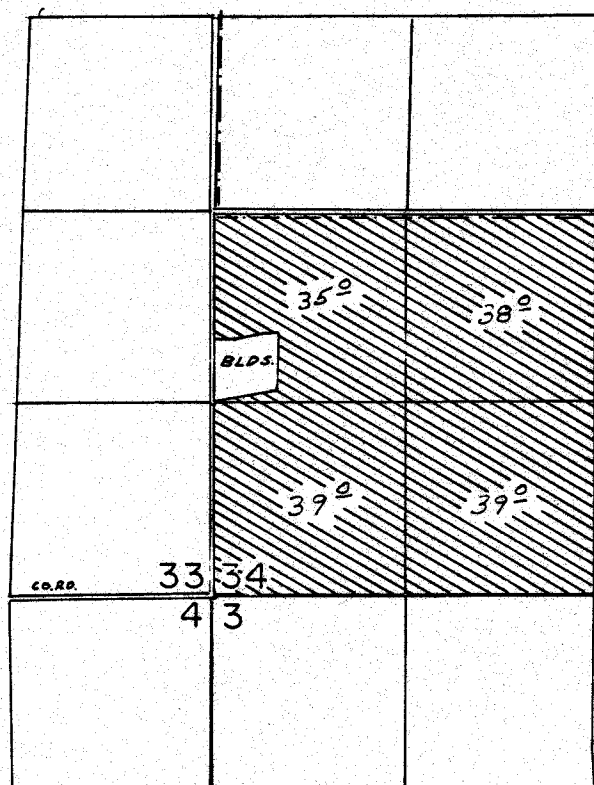

FINAL PROOF SURVEY

UNDER

Application No. 45788... Permit No. 34175...
IN NAME OF

DALE R. & ROBERT V. WOOD

Surveyed APR. 3, 1975, by L.H. NUNN