


T.2S. R.2W. W.M.

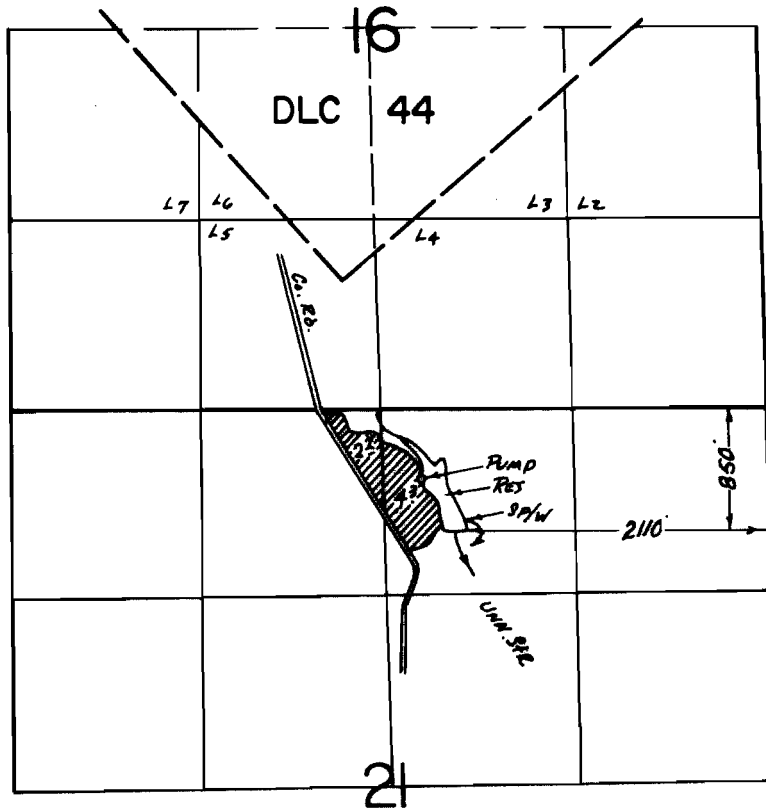

FINAL PROOF SURVEY
UNDER

R-43676 R-4926
Application No.43765. Permit No.32250.
IN NAME OF

.....MELVIN B. WELLS.....

Surveyed June 19, 1974, by R. G. MUCKEN