


T.1S. R.28&3W. W.M.

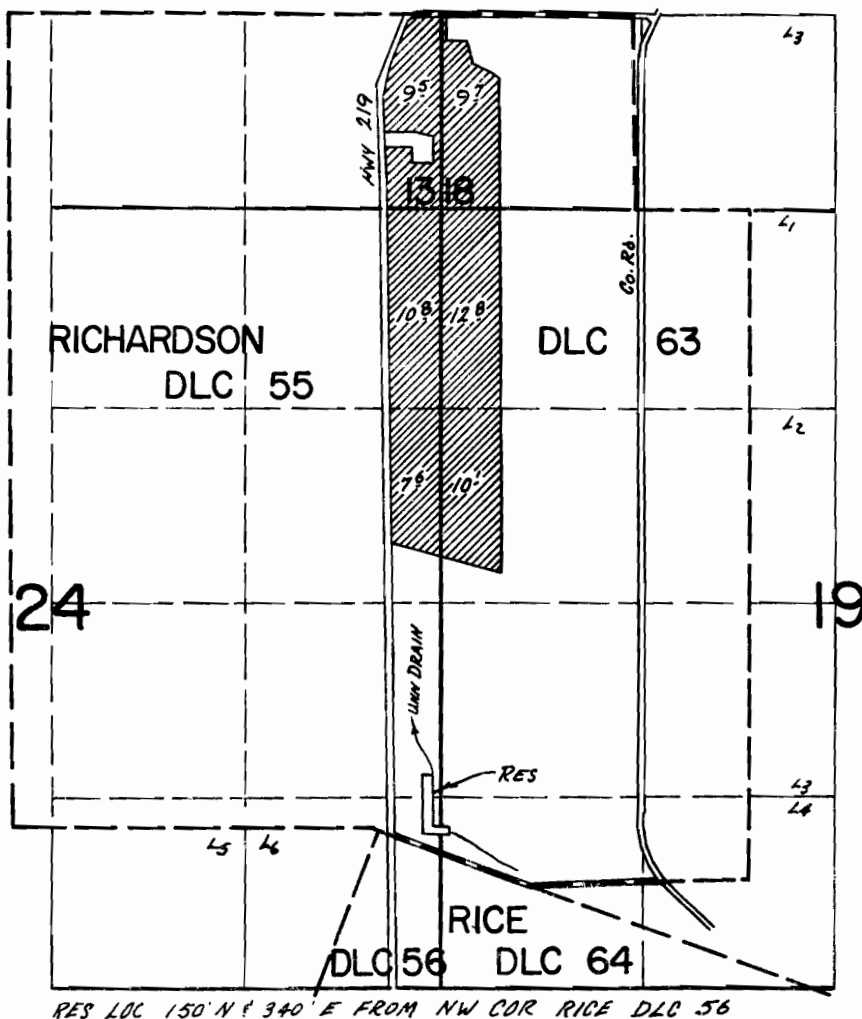

FINAL PROOF SURVEY
UNDER

R-44113 R-5091
Application No. ...44114. Permit No. ...32952
IN NAME OF

.....THOMAS E. WITHYCOMBE.....

Surveyed July...1.... 1974, by R..G...MUCKEN