


T.1N. R.4W.W.M.

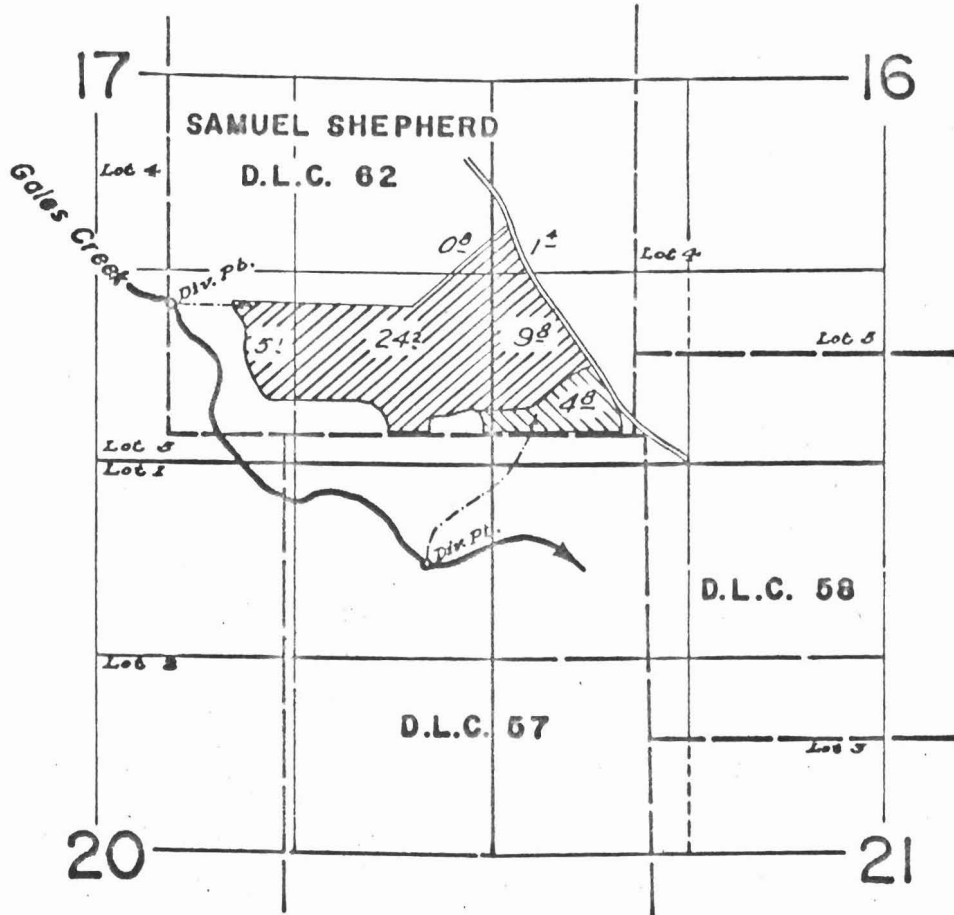

Appl 47327 Per 35454 to bring Q up to
50 per acre & add 6.3 acres prim

FINAL PROOF SURVEY
UNDER

appli No. 47327
Permit No. 35454

Application No. 31029..... Permit No. 24421...
IN NAME OF

Emil Carl Dober

Surveyed August...4 1960, by *Lapperson*