


T.2N. R.2W. W.M.

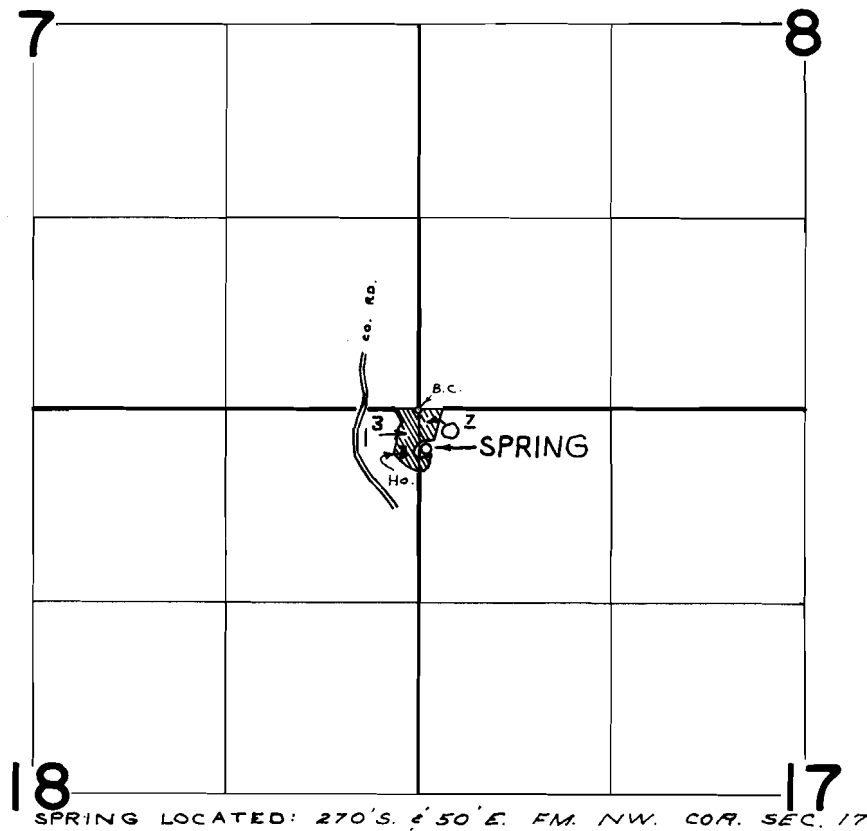

FINAL PROOF SURVEY
UNDER

Application No. 48316 Permit No. 36281
IN NAME OF

CARL R. TANNOCK

Surveyed Sept. 9, 1975, by R. Mucken