


G-5539
C-44339

T.8S., R.25E., W.M.

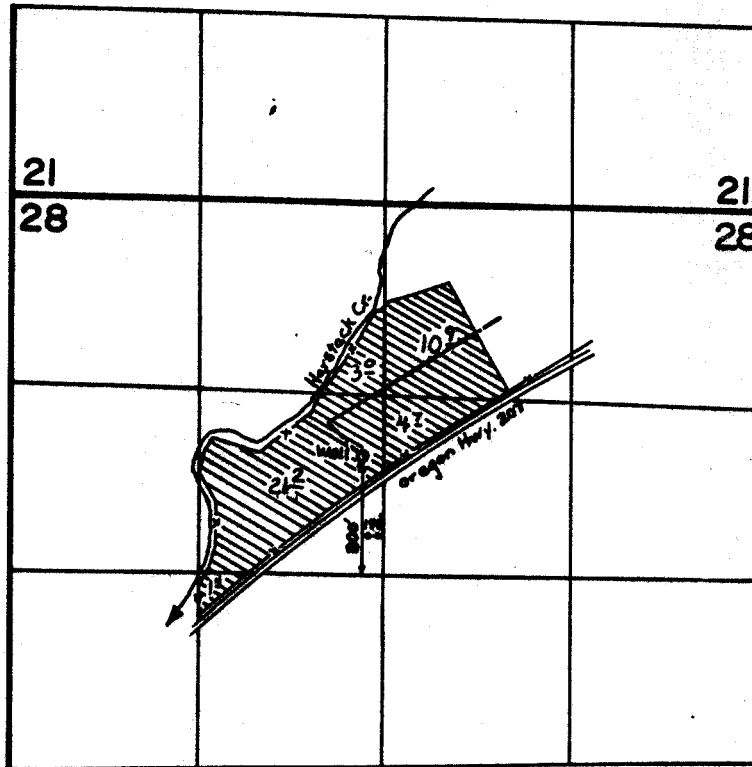

FINAL PROOF SURVEY
UNDER

Application No. G-5753 Permit No. G-5539
IN NAME OF

ROBERT H. & EVA M. WALDEN

Surveyed AUG. 23. 1976. by D. NORBY