


P- 38117

C- 44342

T.8S., R.25E., W.M.

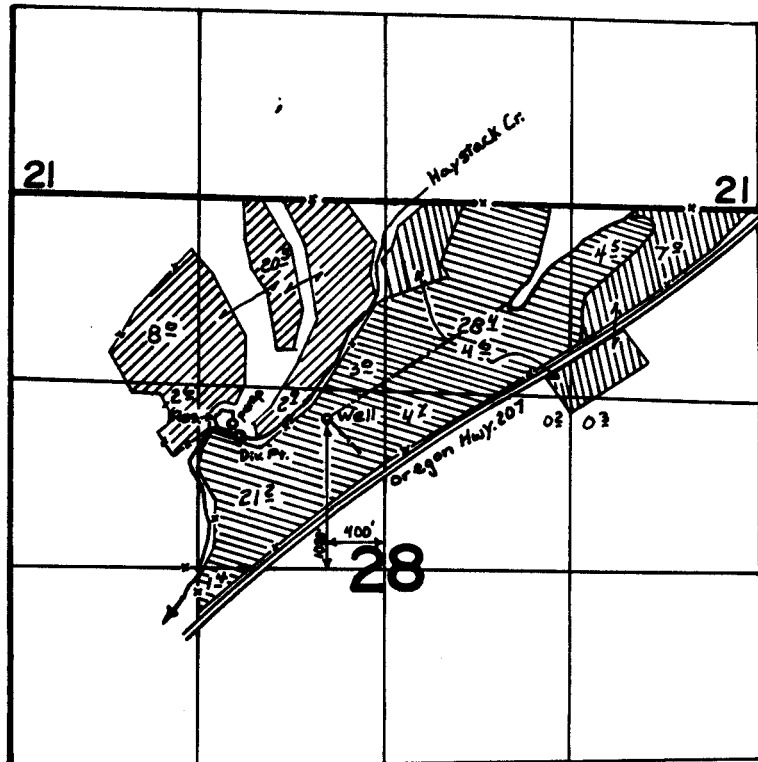

Div. Pt. Located: 900' N & 1000' W from C. 1/4 cor.

- Permit # 38117
 Primary Permit # G-6880
 Supplemental Permit # G-6880

FINAL PROOF SURVEY UNDER

R-52697 R-6169
 50469 38117
 Application No. G-6307 Permit No. G-6880
 IN NAME OF

ROBERT H. WALDEN

Surveyed AUG. 23, 1976, by D. NORBY