


T.10S. R.3W. W.M.

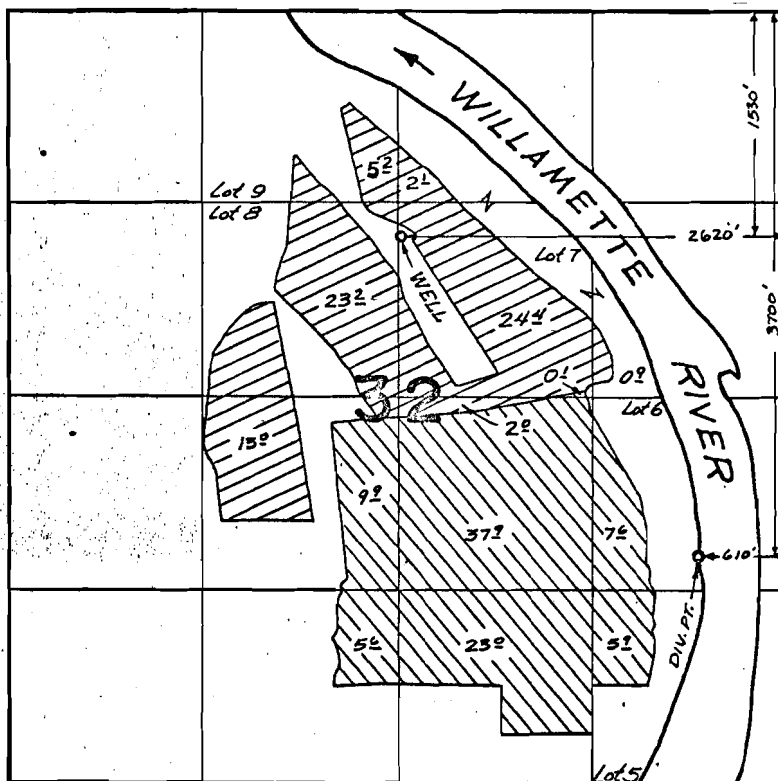

**FINAL PROOF SURVEY**  
UNDER

Application No. 45615 Permit No. 34025  
05960 G5029  
IN NAME OF

MILTON L. COOLEY

Surveyed JULY 2 1974 by L.M. TOLL