


T.14S., R.8W., W.M.

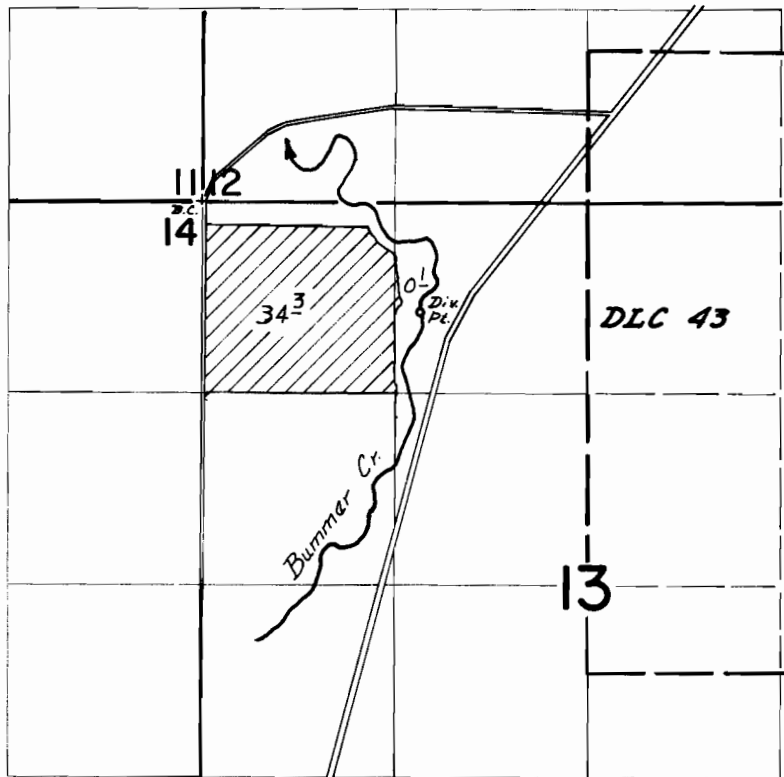

DIV. PT. LOC.: 750' S & 1490' E FROM NW COR. SEC 13.

FINAL PROOF SURVEY
UNDER

Application No. 46903 Permit No. 35089
IN NAME OF

LEWIS R. STEEPROW

Surveyed July 2 1975, by D. Norby