


T.15S., R.5W., W.M.

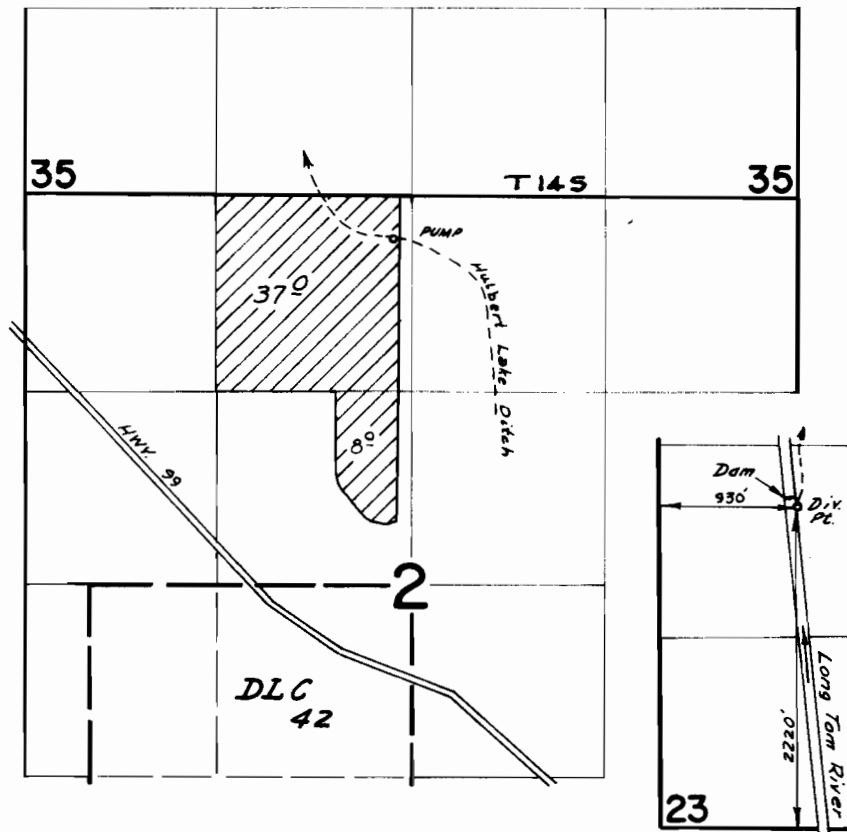

**FINAL PROOF SURVEY**  
UNDER

Application No. 47200 Permit No. 35701  
IN NAME OF

VERA P. HUBBARD

Surveyed April 23 1975, by D. Norby