


T.2S. R.3E. W.M.

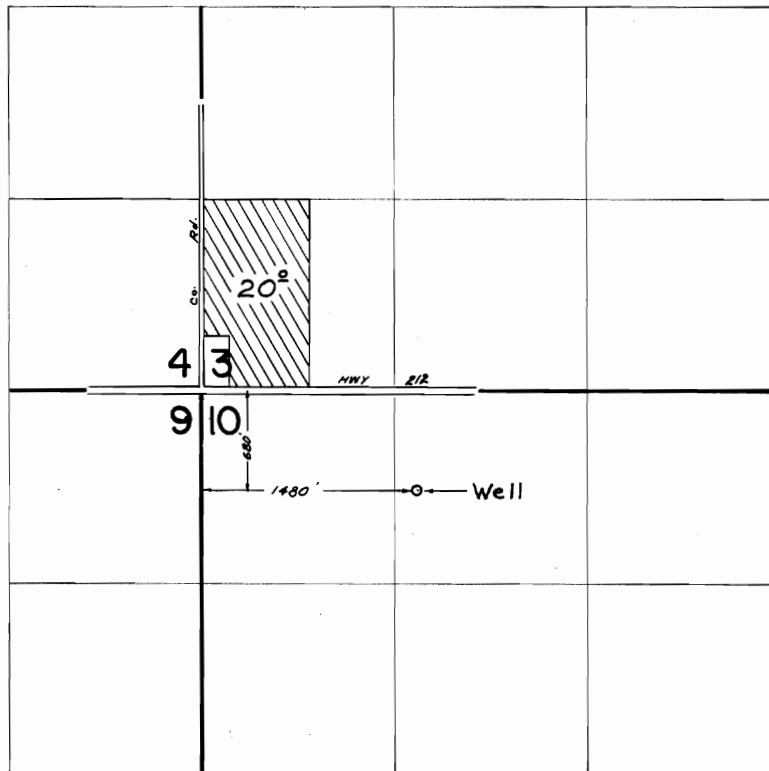

FINAL PROOF SURVEY
UNDER

Application No. G-5492 Permit No. G-5156
IN NAME OF

MAS FUJIMOTO

Surveyed Oct. 2, 1974, by L.E. GOULD