


T.6N., R.2W., W.M.

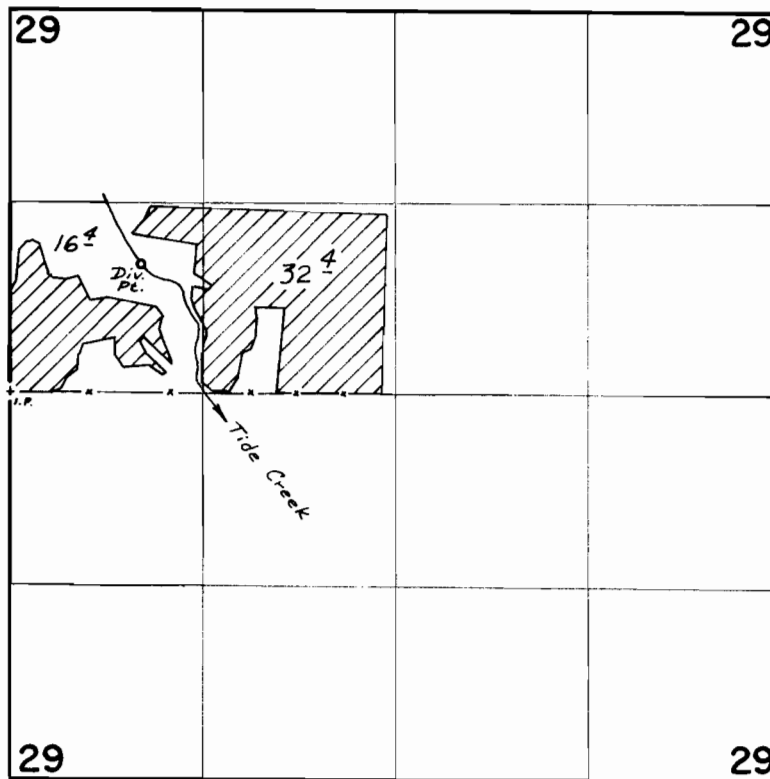

DIV. PT. LOC: 880' N & 900' E FROM W 1/4 COR SEC 29.

FINAL PROOF SURVEY
UNDER

Application No. 42376 Permit No. 31725
IN NAME OF

MELVA N. AND DOLORES N. KELLY

Surveyed Sept. 30 1975, by D. Norby