


T.6N., R.2W., W.M.

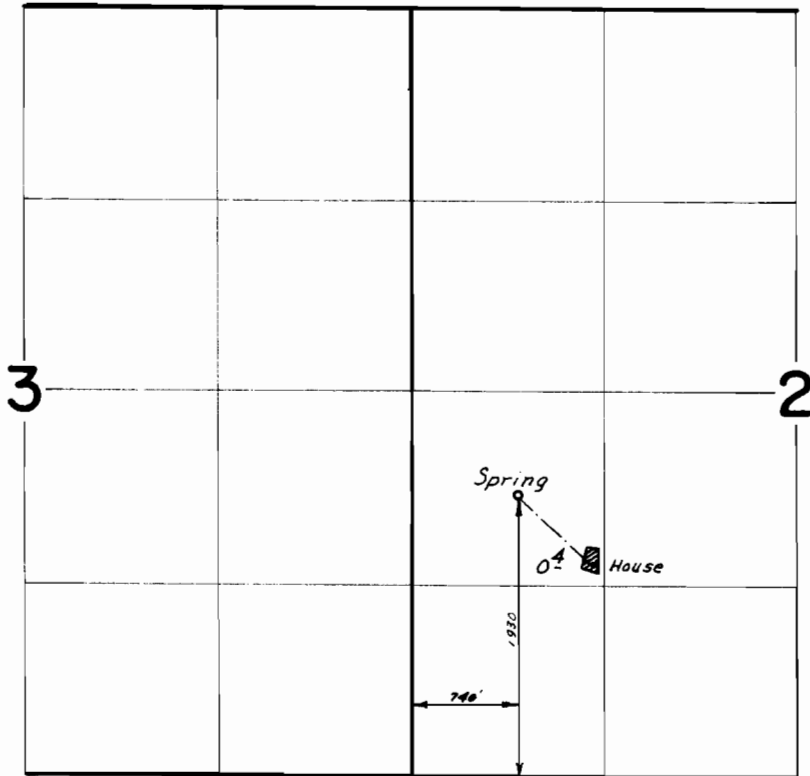

FINAL PROOF SURVEY
UNDER

Application No. 46165 Permit No. 34488
IN NAME OF

WILLIAM J. TEZAK

Surveyed Sept. 30 1975, by D. Norby