


T.4N. R.2W. W.M.

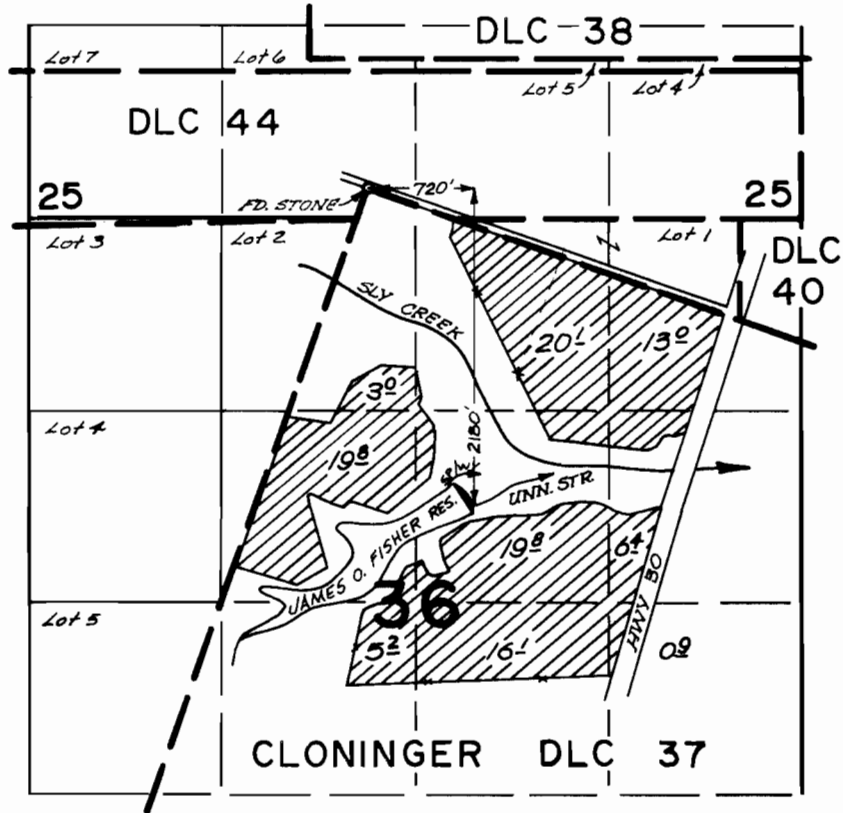

FINAL PROOF SURVEY UNDER

Application No. ⁴⁶⁹⁹⁴ ~~R.46993~~ Permit No. ³⁴⁸⁸⁵ ~~R.5582~~
IN NAME OF

JAMES O. FISHER

Surveyed JUNE 12, 1975, by R.G. MUCKEN