


T. 4 N. R. 2 W. W.M.

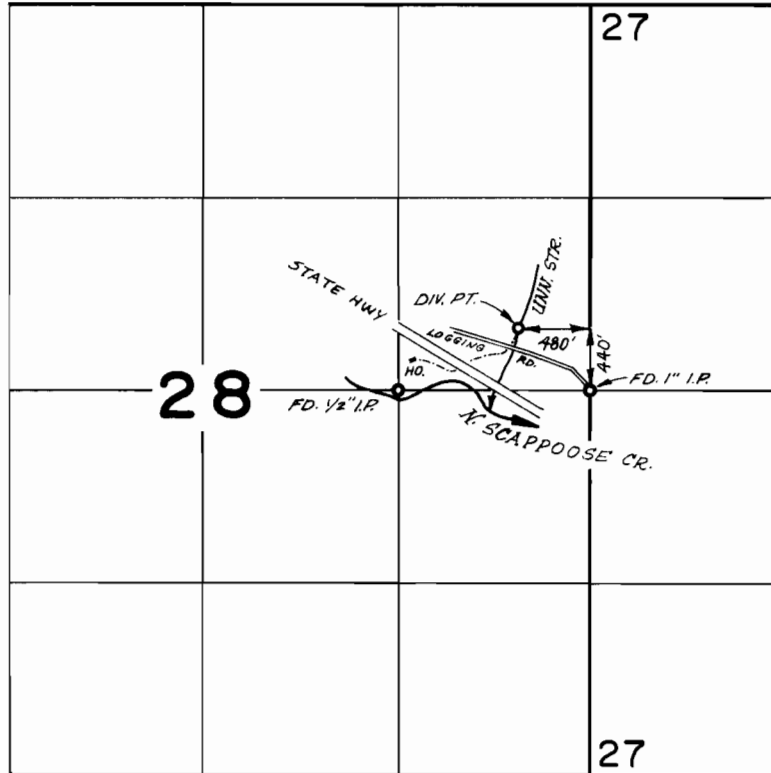

**FINAL PROOF SURVEY**  
UNDER

Application No. 47207 Permit No. 35360  
IN NAME OF

ROBERT H. ROBINSON

Surveyed JUNE 10 1975, by R.G. MUCKEN