


T. 4N. R. 4&5W. W.M.

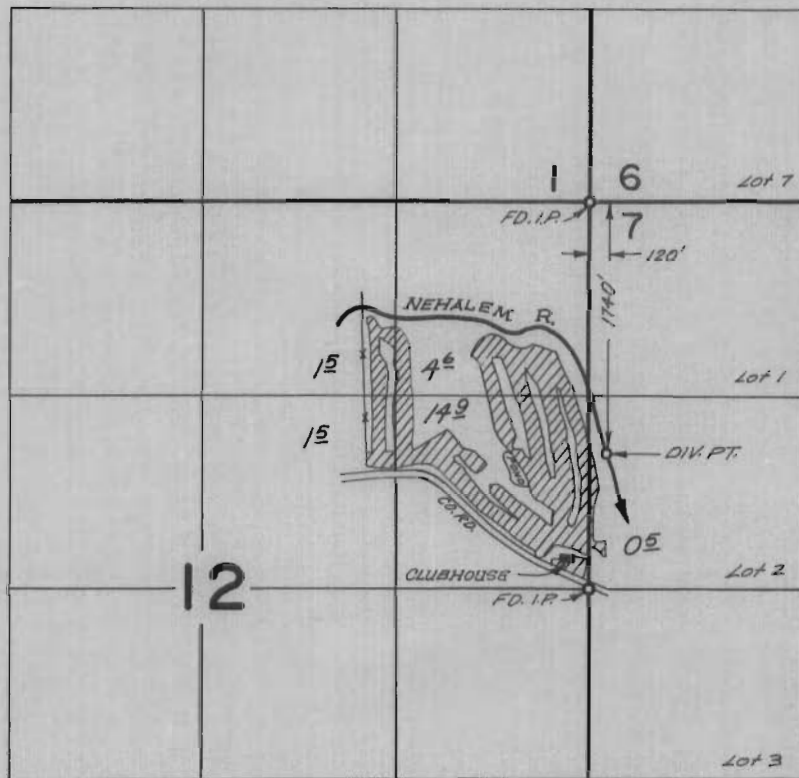

FINAL PROOF SURVEY UNDER

Application No. 47700 Permit No. 35734
IN NAME OF

BEAVER SPORTS PROPERTIES

Surveyed AUG. 14, 1975, by R.G. MUCKEN