


T. 7 N., R. 3 W., W.M.

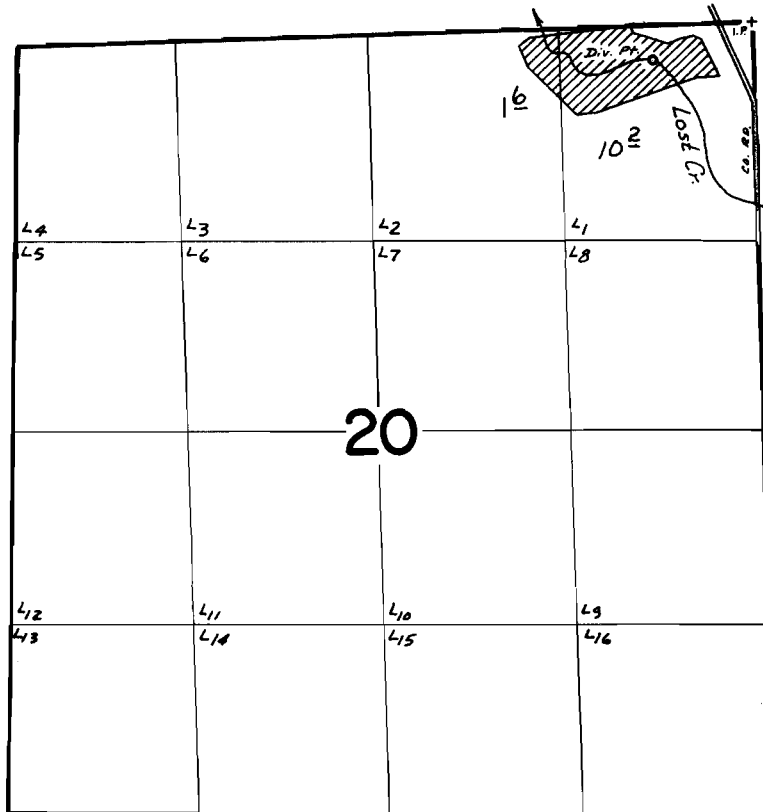

DIV. PT. LOC.: 270' S & 680' W FROM NE COR SEC. 20.

FINAL PROOF SURVEY
UNDER

Application No. 49934 Permit No. 37579
IN NAME OF

ESTATE OF HOMER W. HARRISON

Surveyed Oct. 1 1975, by D. Norby