


T.28 S. R.10 W. W.M.

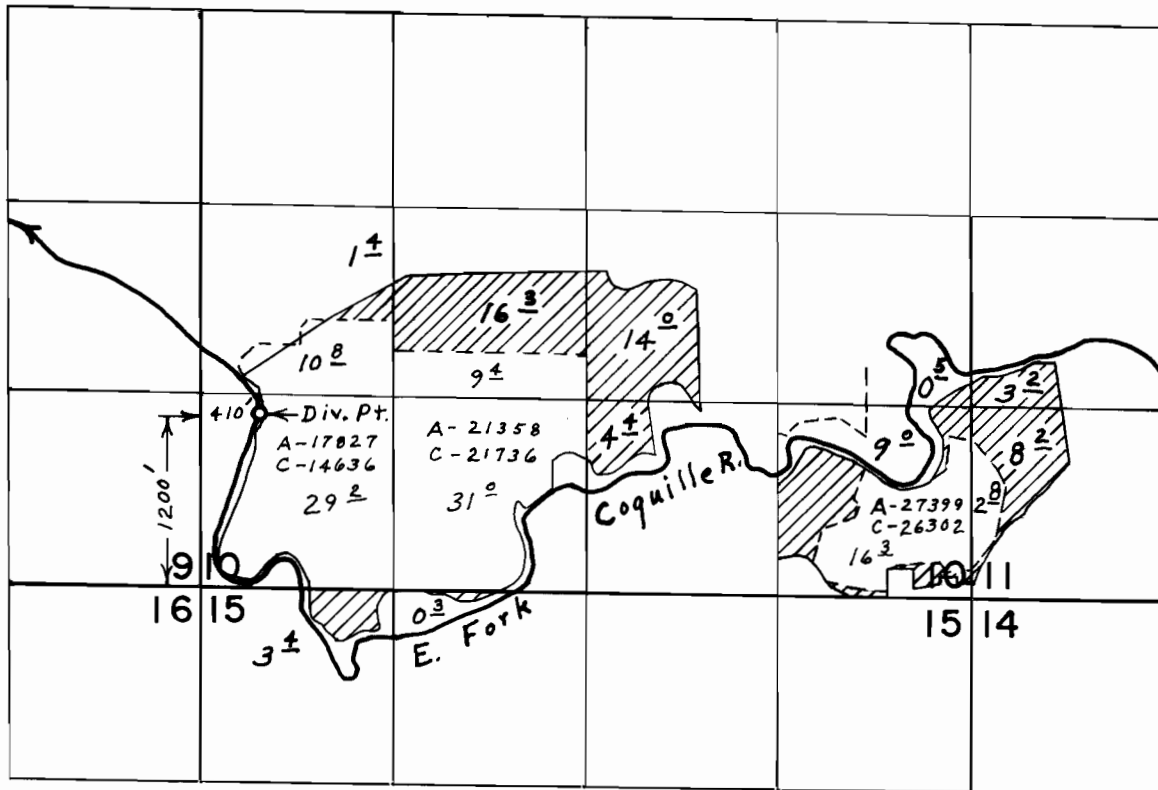

FINAL PROOF SURVEY
UNDER

Application No. 45652 Permit No. 34045
IN NAME OF
CALVIN LAIRD

Surveyed Oct. 28, 1975, by L. E. Gould