


T.29 S. R.11 W. W.M.

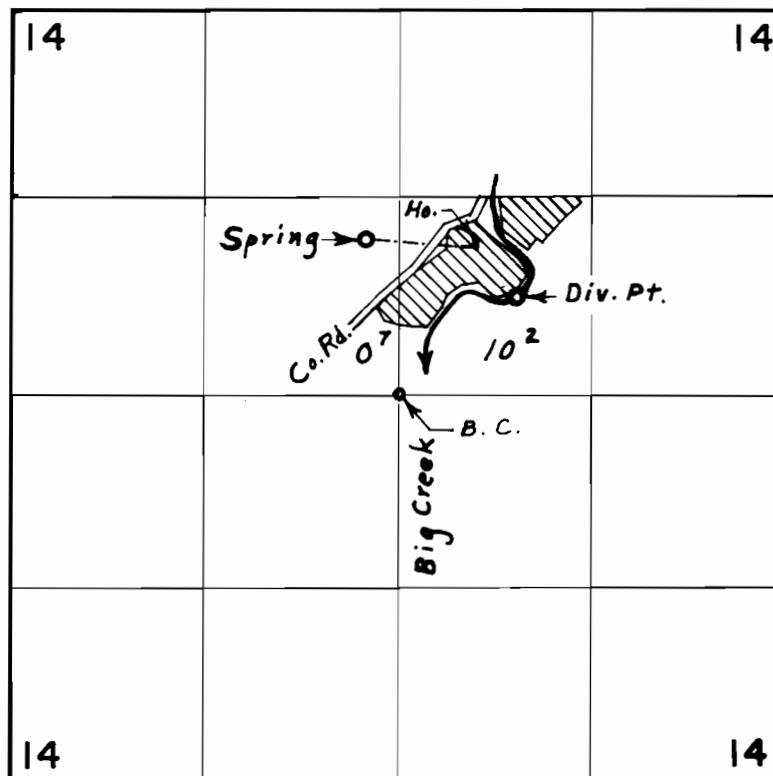

Div. Pts. located: Spr., 1080' N. & 230' W.; Creek,
680' N. & 800' E., both from Center Section 14

FINAL PROOF SURVEY
UNDER

Application No. 47706 Permit No. 35738
IN NAME OF

GERALD LEROY & AMY LEE CARPENTER

Oct. 29, 1975 by L. E. Gould
Surveyed July 13, 1972, by R. Mucken