


T.26S.,R.12&13W.,W.M. .

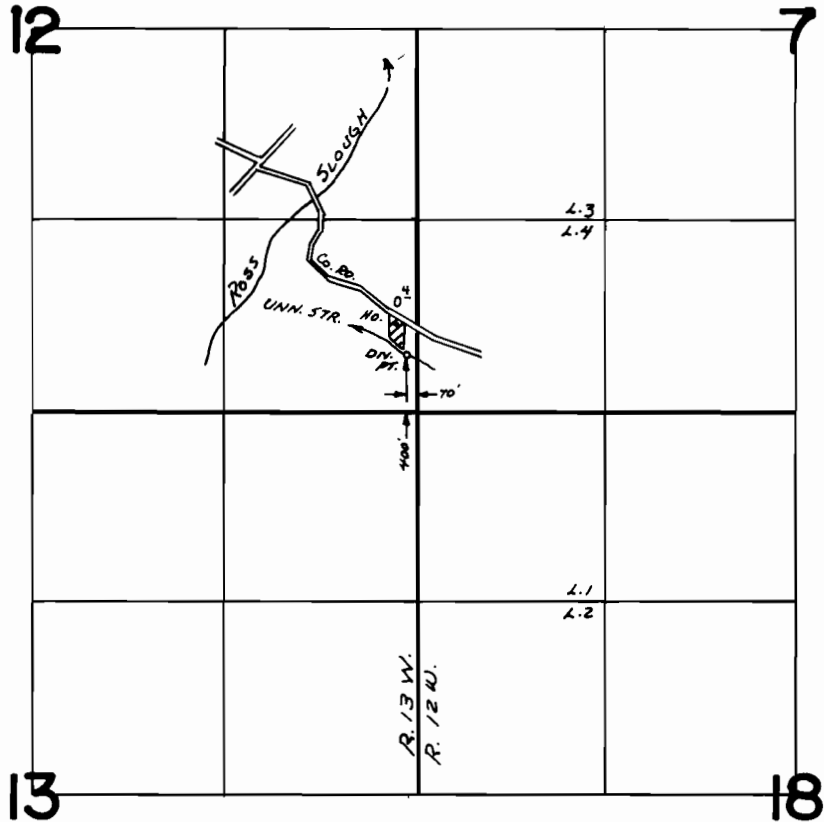

FINAL PROOF SURVEY
UNDER

Application No. ...48691... Permit No. ...36509..
IN NAME OF

.....NORMAN L. SELTHON.....

Surveyed *May 27* 1976, by *L. Toll*.....