


T.26S., R.12W., W.M.

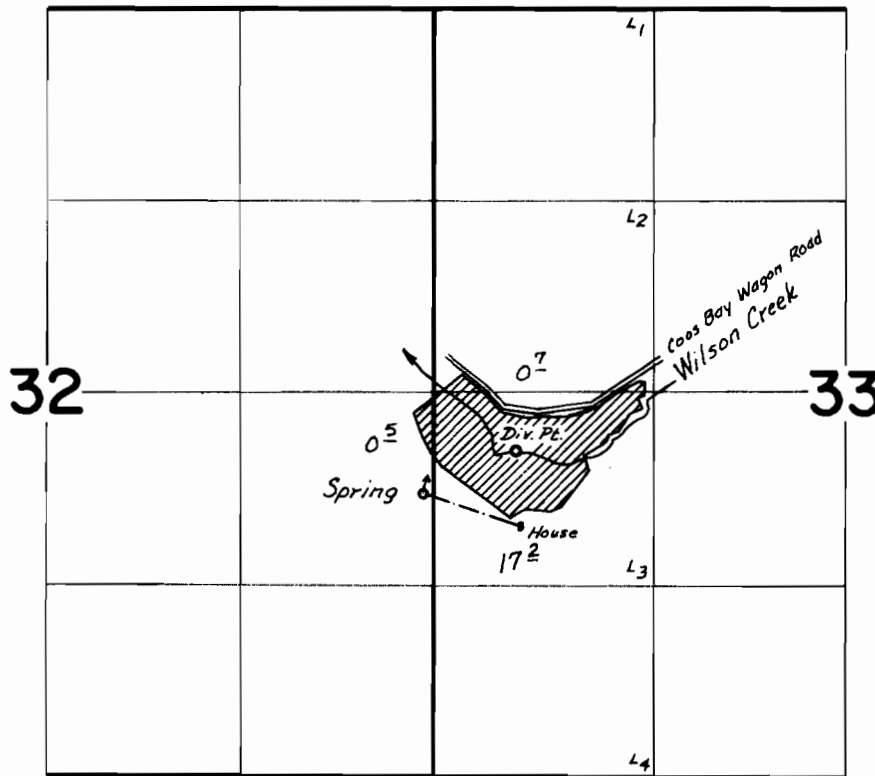

DIV. PTS. LOC: CR. - 410'S & 560' E; SPR. - 700'S & 70' W FROM W 1/4 COR. SEC. 33

**FINAL PROOF SURVEY**  
UNDER

Application No. 50026 Permit No. 37611  
IN NAME OF  
**CLARENCE C. AND CAROLINE R. ALVES**  
Surveyed Sept. 24 1975, by D. Norby