


T.41S. R.12W. W.M.

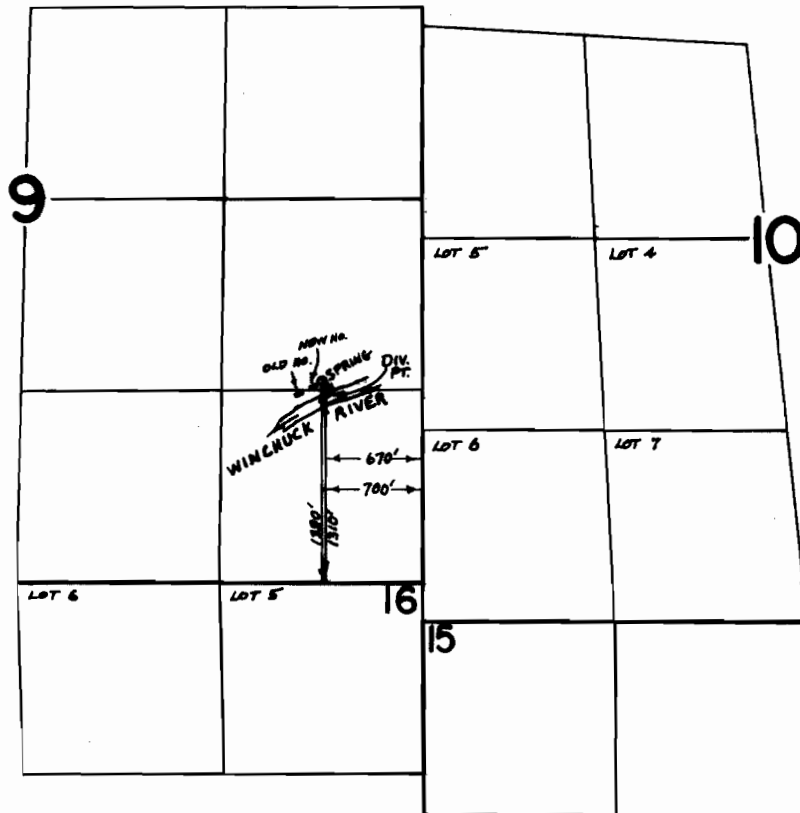

FINAL PROOF SURVEY
UNDER

Application No. 43221 Permit No. 32144
IN NAME OF

CLIFFORD J. WYNKOOP

Surveyed JULY 19 1975, by L. TOLL