


T. 39S. R. 14W. W.M.

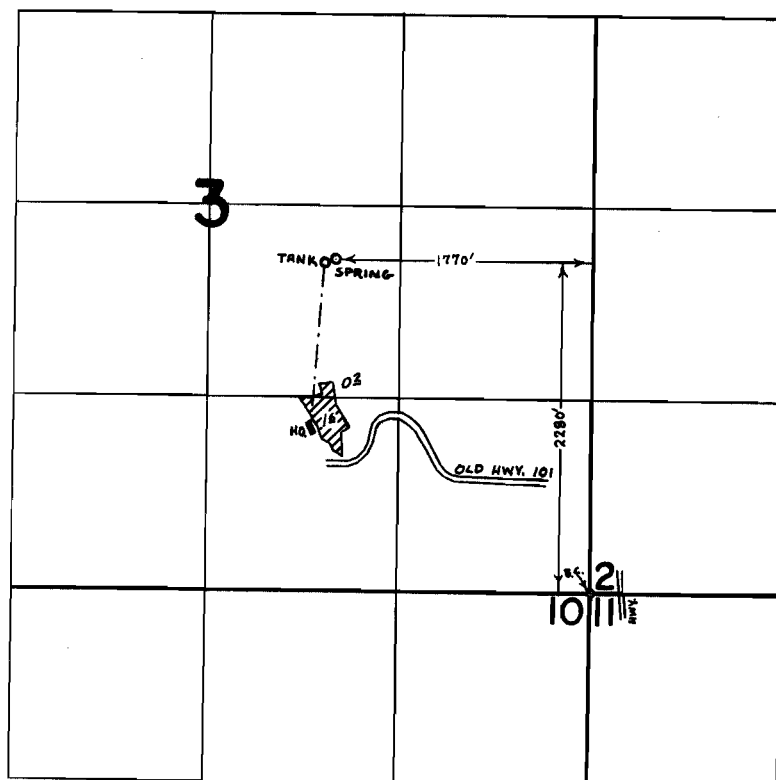

FINAL PROOF SURVEY
UNDER

Application No. 48101 Permit No. 36123
IN NAME OF

WILLIAM F. & ROSE HARKLER ROAD

Surveyed JULY 21 1975, by L. TOLL