


T.39S. R.14W. W.M.

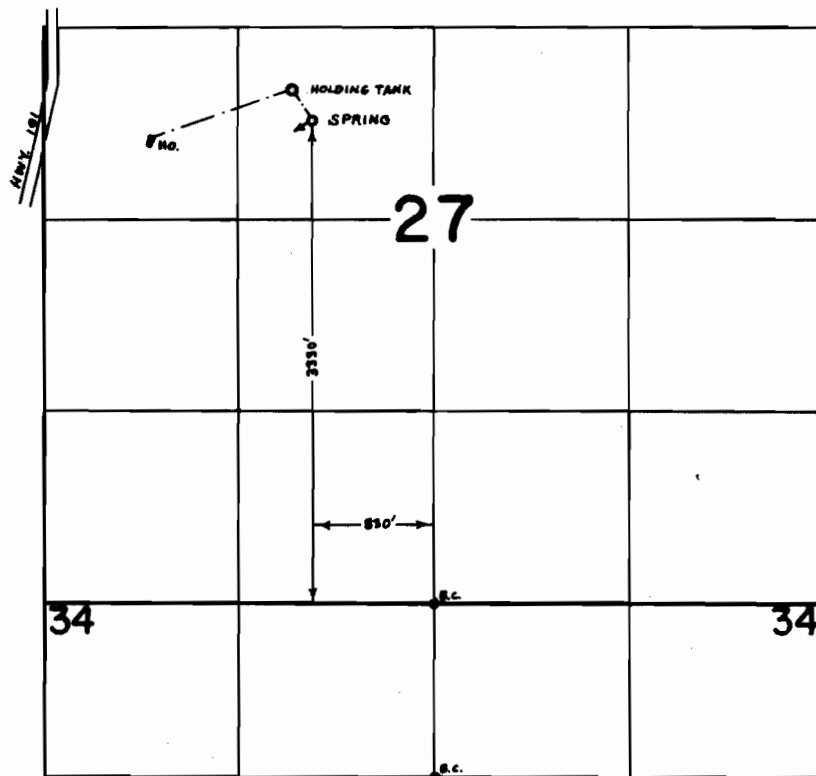

FINAL PROOF SURVEY
UNDER

Application No. 50778 Permit No. 37519
IN NAME OF

PAUL V. & MARJORY M. HANSEN

Surveyed JULY 22 1975, by L. TOLL