


# T.30S. R.5 & 6 W. W.M.

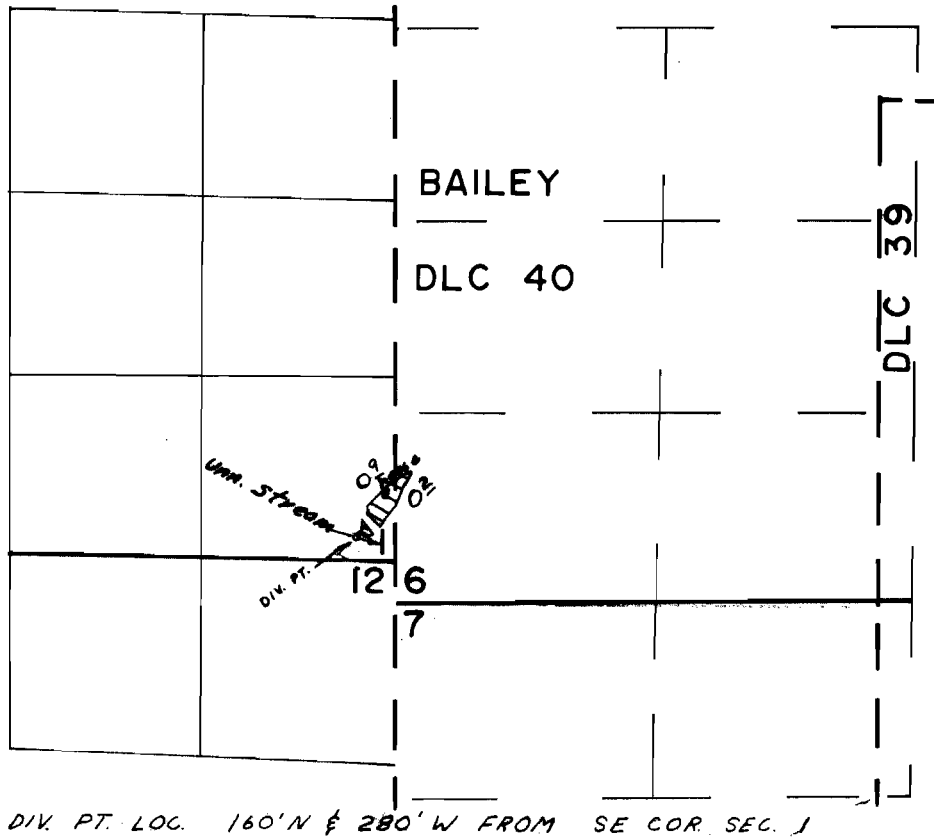

## FINAL PROOF SURVEY UNDER

Application No. 50583 Permit No. 37418  
IN NAME OF

DARREL GREEN

Surveyed OCT. 20, 1975., by LH NUNN