


P-28466

28466

44374

T 12 S. R. 33 E. W.M.

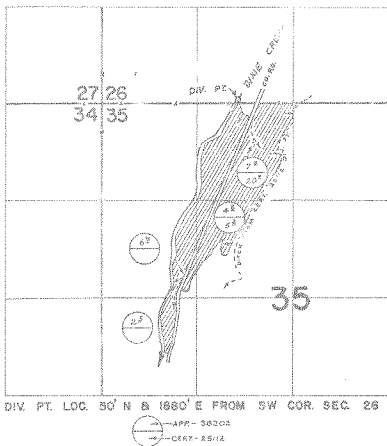

FINAL PROOF SURVEY UNDER

Application No. 38202... Permit No. 28466... C-44374
IN NAME OF

HENRY. RICCO

SURVEYED JUNE 20 1975
AUG. 28, 1971, by R. MUCKEN