


P-35181
C

T.13S., R.28E., W.M.

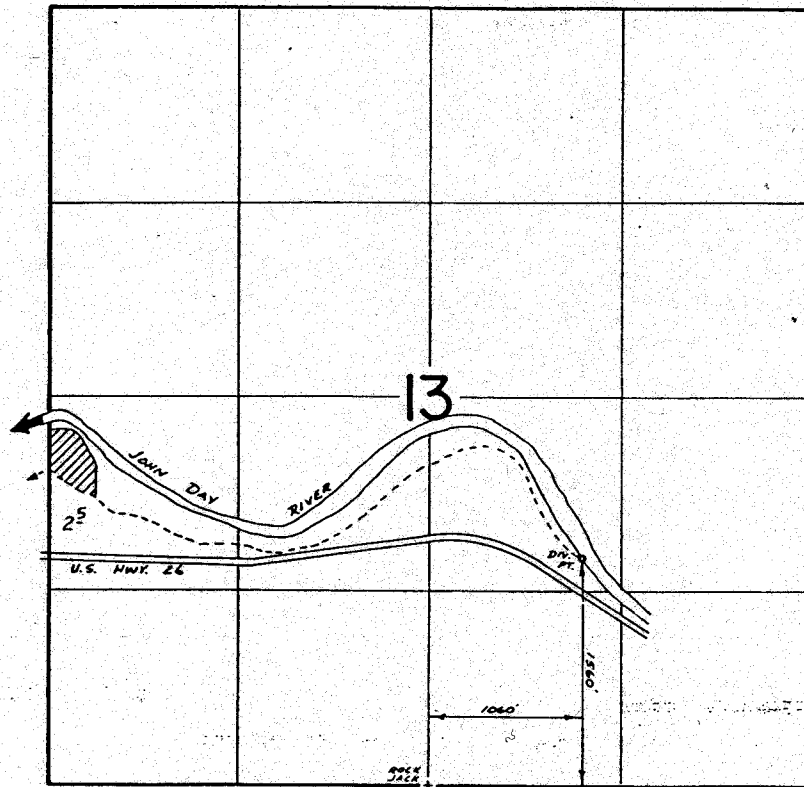

FINAL PROOF SURVEY
UNDER

Application No. 47036 Permit No. 35181
IN NAME OF

EUGENE AND MANDY LIPPERT

Surveyed June 21 1975, by D. Norby

C-44375