


1-51303  
C-44377

# T.13S. R.31E. W.M.

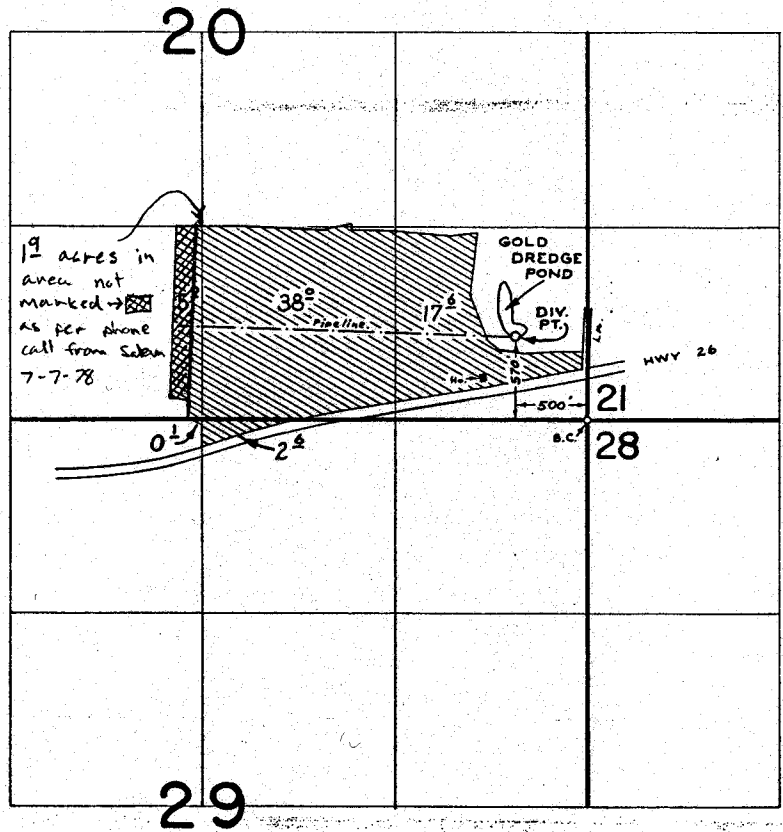

NOTE: 2nd Cont'd  
Luce Lang. 10/1/75

## FINAL PROOF SURVEY UNDER

Application No. 49963 Permit No. 37585  
IN NAME OF  
SIM G. HENDRIX

C-44377

Surveyed JUNE 26, 1975, by R. MUCKEN