


T.25 S.R.30 E.W.M.

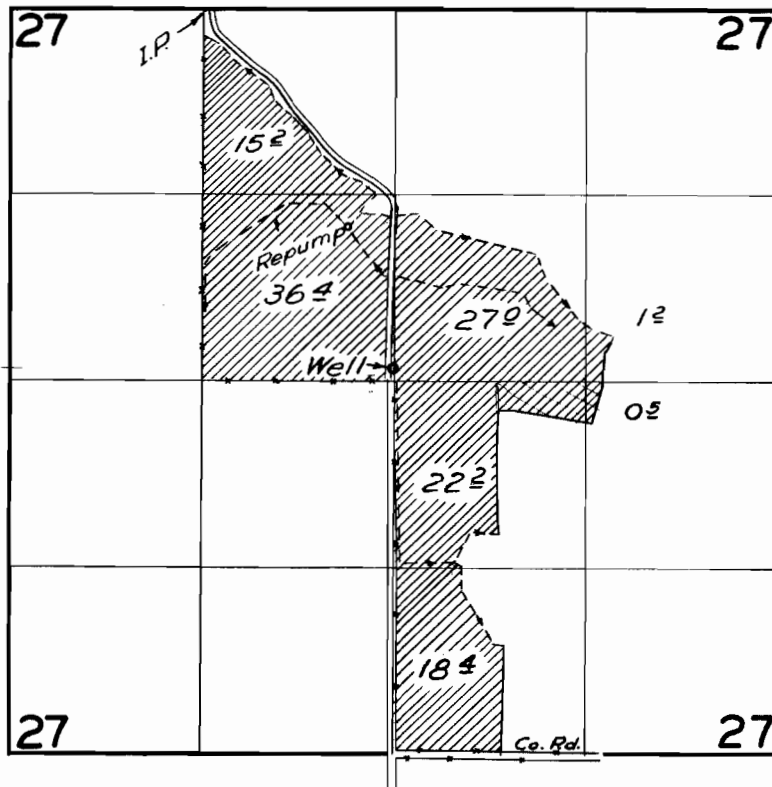

FINAL PROOF SURVEY
UNDER

Application No. U-436 Permit No. U-407
IN NAME OF

JAMES E. DUNN

Surveyed 13 Aug. 1959, by M. B. Bish