


T.36S.,R.3W.,W.M.

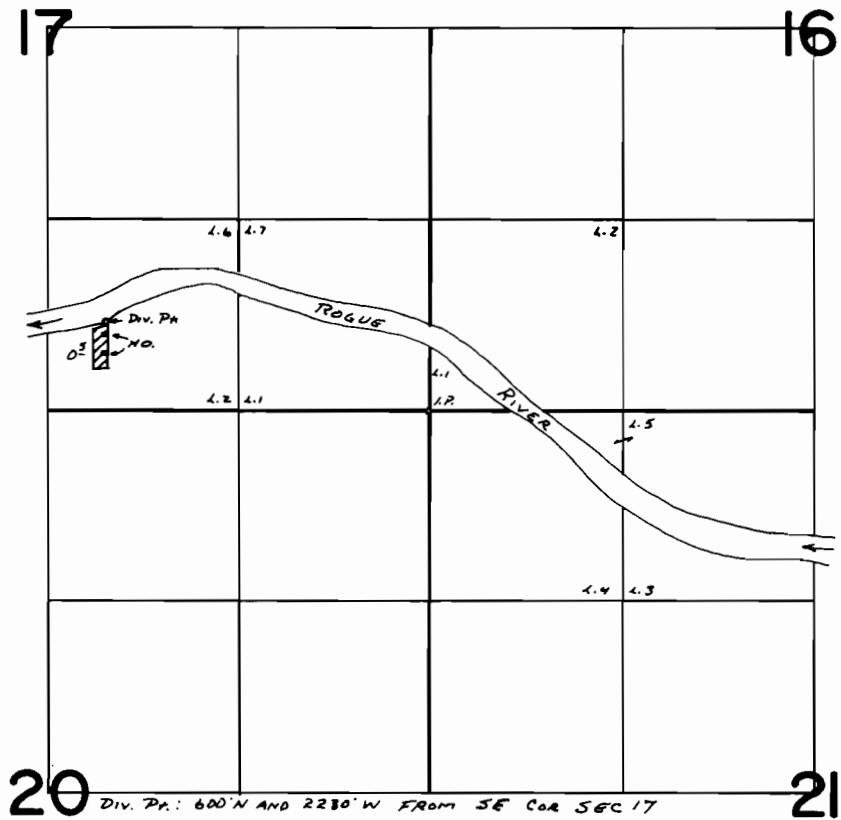

FINAL PROOF SURVEY
UNDER

Application No. 48328 Permit No. 36291
IN NAME OF

KERN DRILLING CORP.

Surveyed Aug. 13, 1975, by L. E. Gould