


T.11S.,R.13E.,W.M.

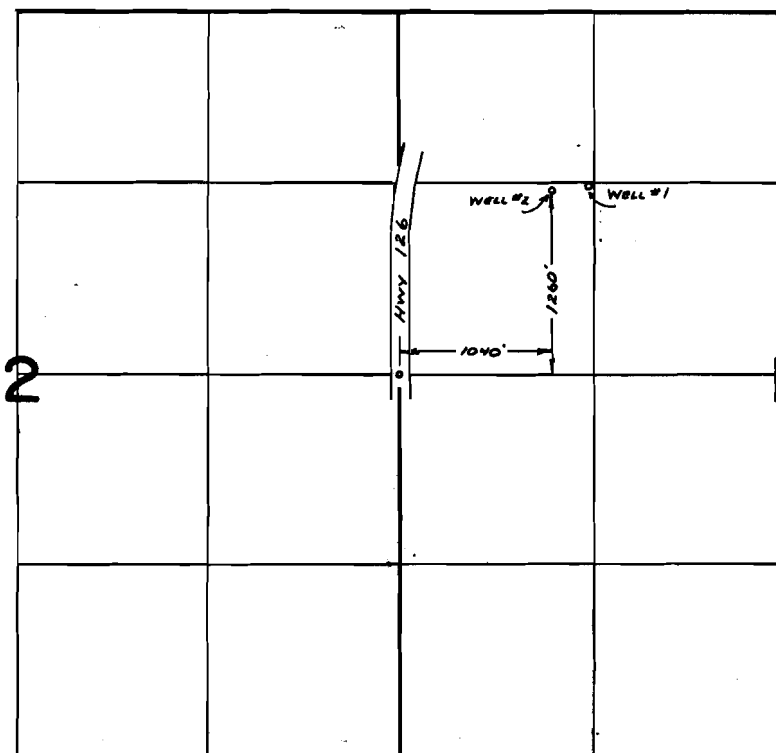

FINAL PROOF SURVEY UNDER

Application No. ..G-3260 Permit No. ..G-3058
IN NAME OF

.....CITY OF MADRAS.....

Surveyed JUNE..10. 19.75, by L. E. GOULD.....