


T.37S. R.6W. W.M.

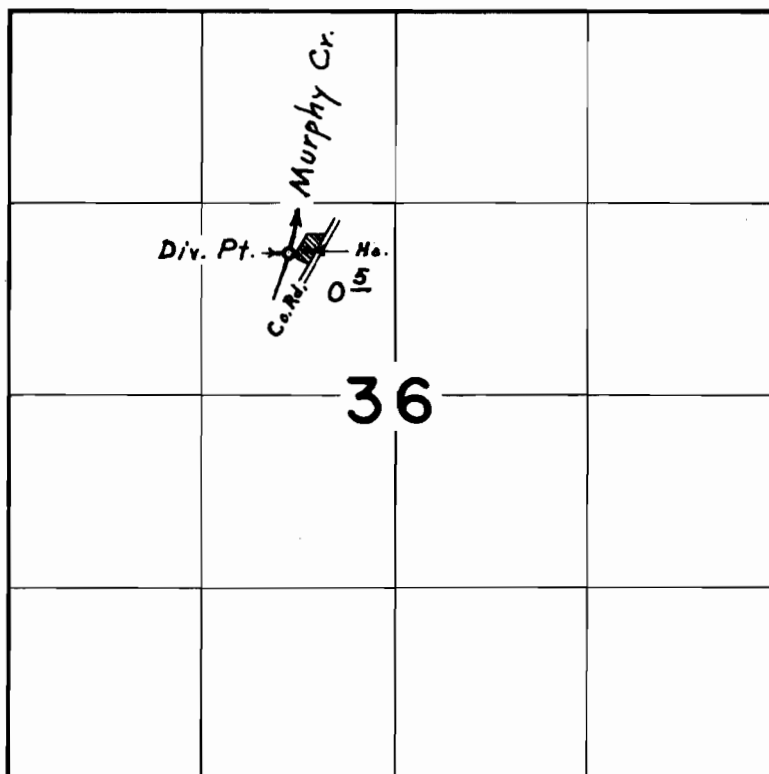

FINAL PROOF SURVEY
UNDER

Application No. 45053 Permit No. 33668
IN NAME OF

ARTHUR L. & JUNE E. SHARP

Surveyed Sept. 17, 1975, by L. E. Gould