


T.37S. R.7 W. W.M.

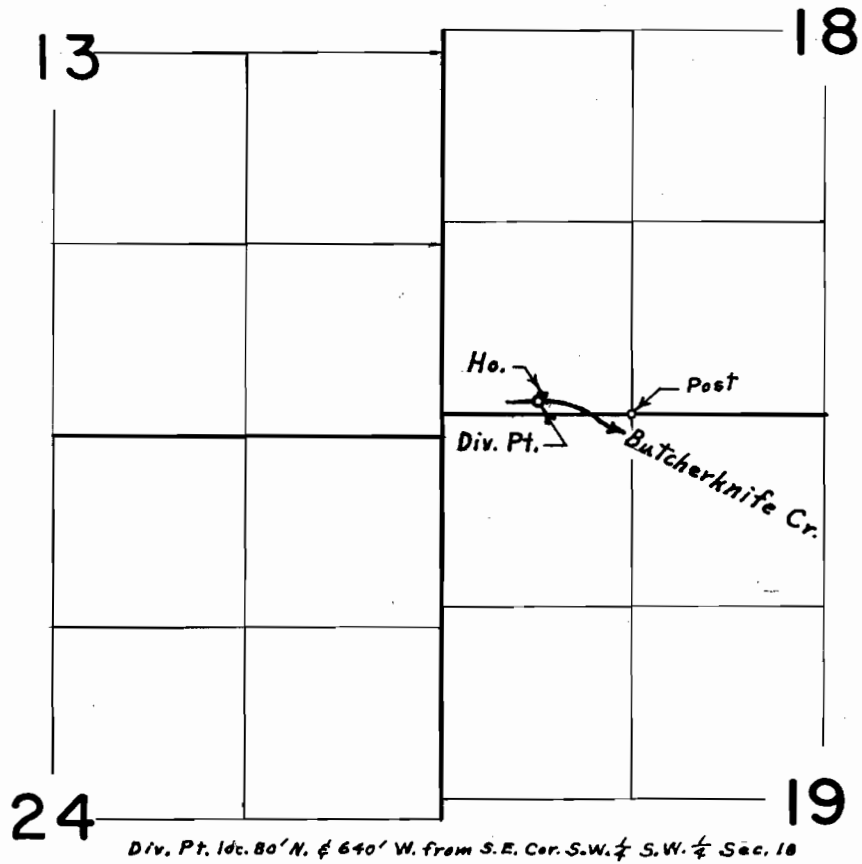

FINAL PROOF SURVEY
UNDER

Application No. 45269 Permit No. 33807
IN NAME OF

MARVIN D. SPRINKLE

Surveyed Sept. 18, 1975, by L. E. Gould