


T.36S. R.7 W. W.M..

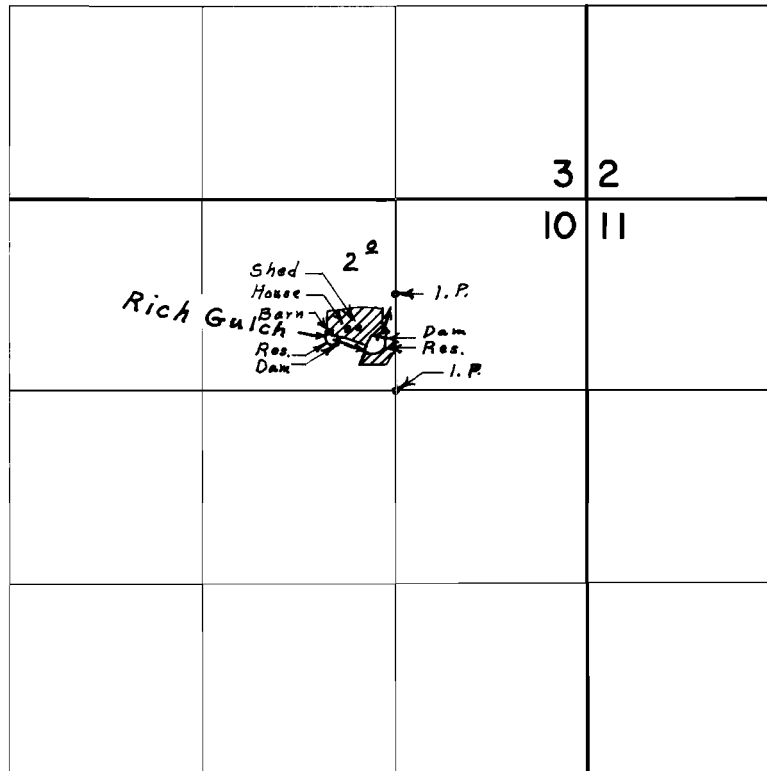

Div. Pts. located: Res. #1, 380' N. & 120' W.; Res. #2, 330' N. & 380' W., both from S.E. Cor. N.W. & N.E. $\frac{1}{4}$ Section 10

FINAL PROOF SURVEY
UNDER

R-46243 R-5529
Application No. ~~46244~~ Permit No. ~~34668~~
IN NAME OF
W. A. HUBBARD

Surveyed April 10, 1975, by L. E. Gould