


T.40S.,R.8W.,W.M.

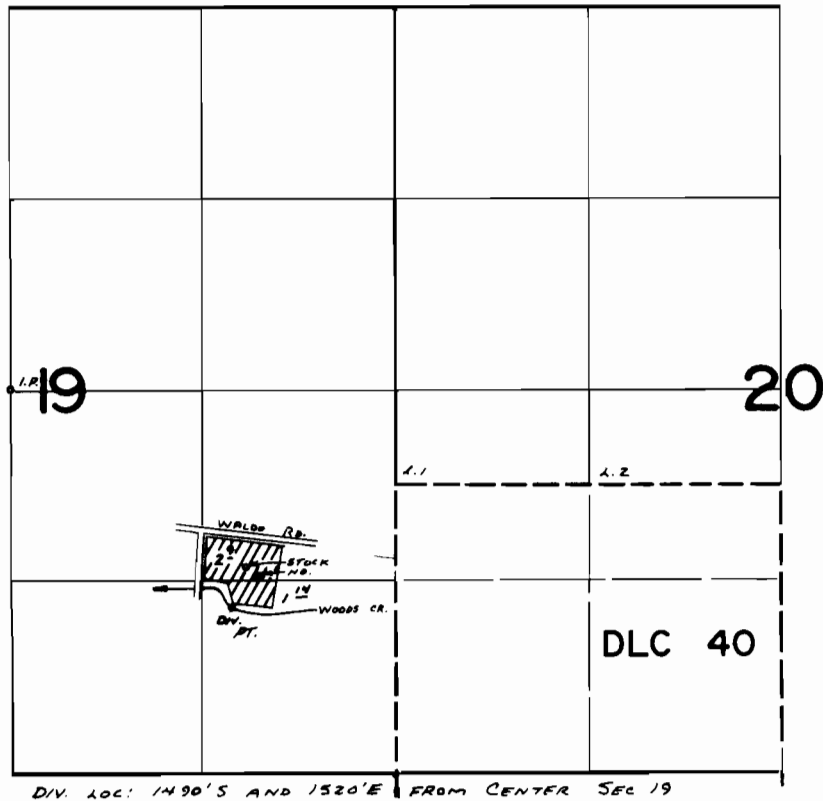

FINAL PROOF SURVEY UNDER

Application No. 46663 Permit No. 34731
IN NAME OF

FRANK T. & NINA E. ETZWILER

Surveyed APRIL 30 1975, by L. Toll