


T.37S. R.6W. W.M.

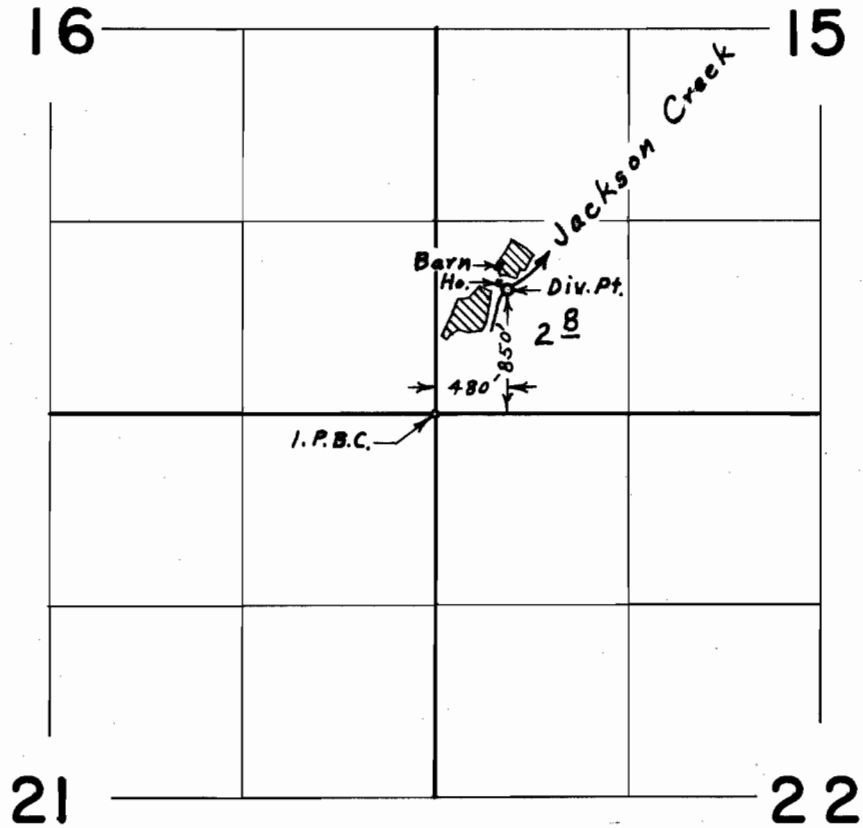

**FINAL PROOF SURVEY**  
UNDER

Application No. 47491 Permit No. 35569

IN NAME OF

**VICTOR POINDEXTER**

Surveyed Sept. 17, 1975, by L. E. Gould