


T.39S. R.5W. W.M.

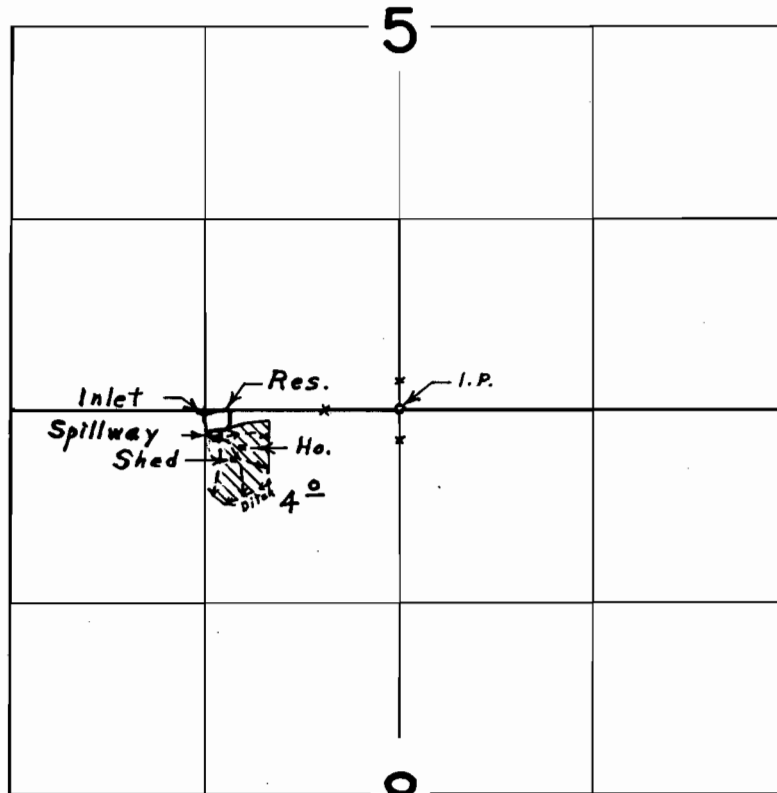

Div. Pt. located 150' S. & 1300' W. from N.  $\frac{1}{4}$  Cor. Sec. 8

**FINAL PROOF SURVEY**  
UNDER

Application No. R-49376 49377 Permit No. R-6008 37011  
IN NAME OF

ALLEN P. CARRE

Surveyed Sept. 15, 1975, by L. E. Gould