



T.37 & 38 S., R.10 E., W.M.

FINAL PROOF SURVEY
UNDER

Application No. 41159 Permit No. 30684
IN NAME OF

BIAGGI-VENABLE

Surveyed Oct. 31 1974, by D.M. Norby

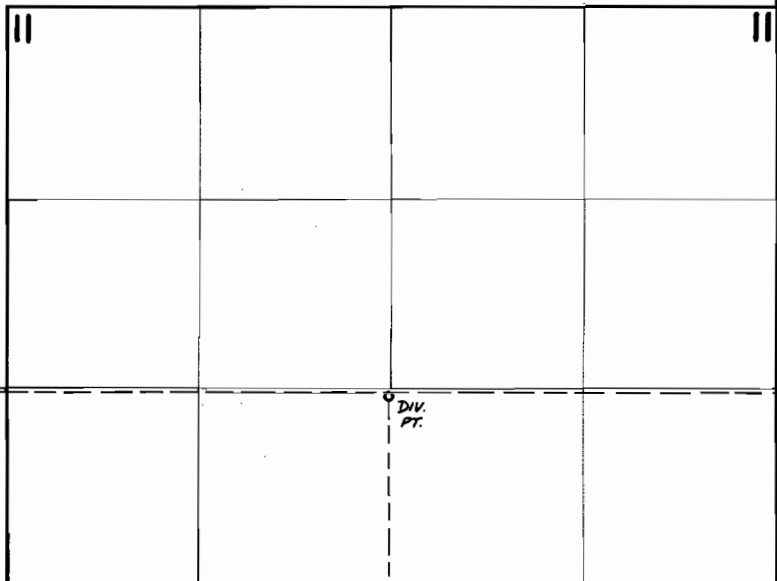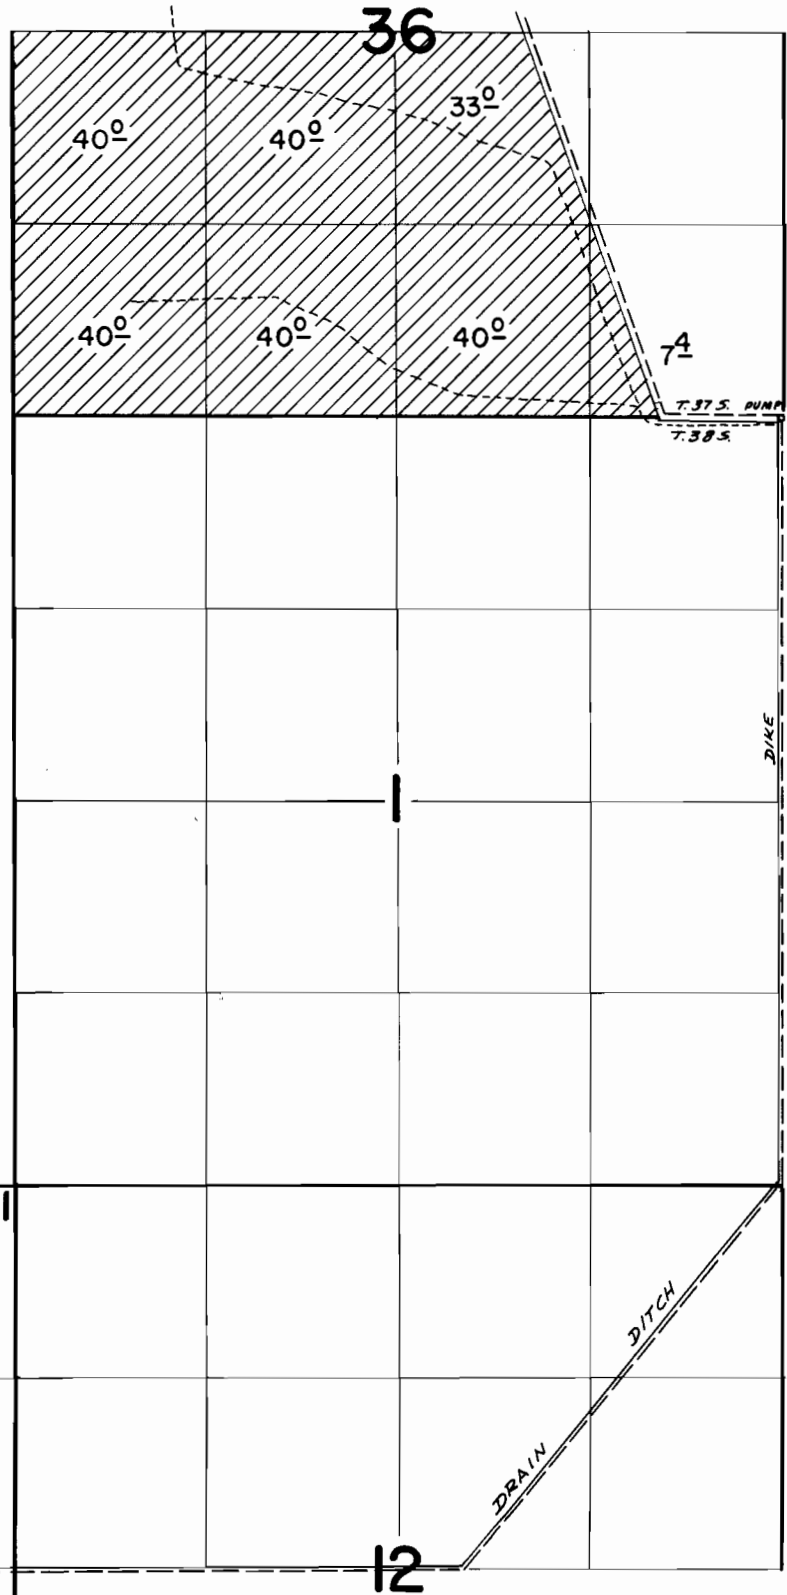

DIV. PT. LOCATED: 20' S & 2650' W FROM E 1/4 COR. SEC. 11.