


32709

44403

T.37S.,R.5E.,W.M.

Staircase etc. misc

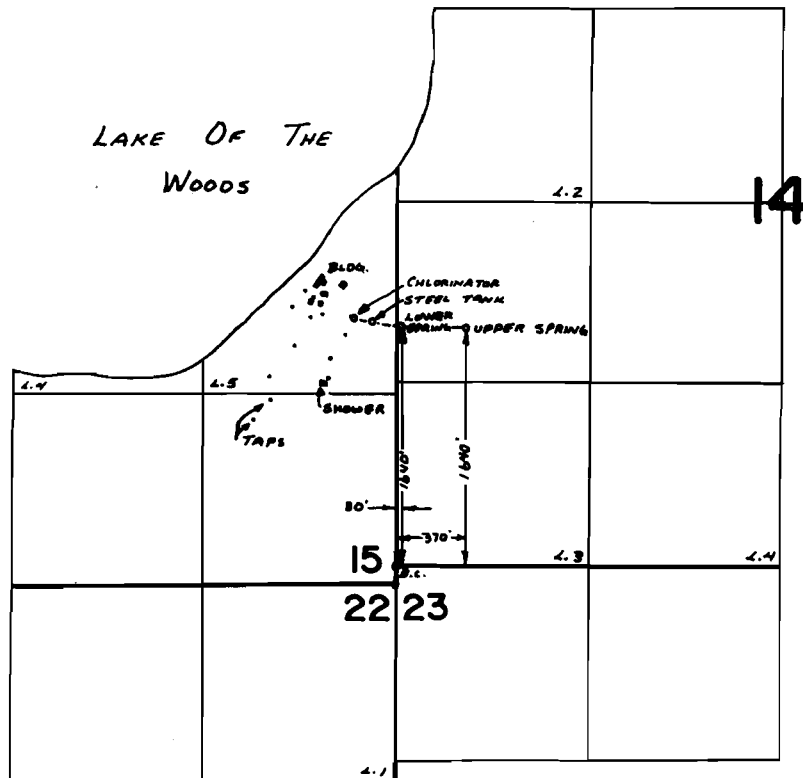

FINAL PROOF SURVEY UNDER

Application No. 43771 Permit No. 32709
IN NAME OF

WINEMA GIRL SCOUT COUNCIL, INC.

Surveyed July 14, 1975, by S. E. GOULD