


34034
44404

T.40S.,R.8E.,W.M.

Klamath River

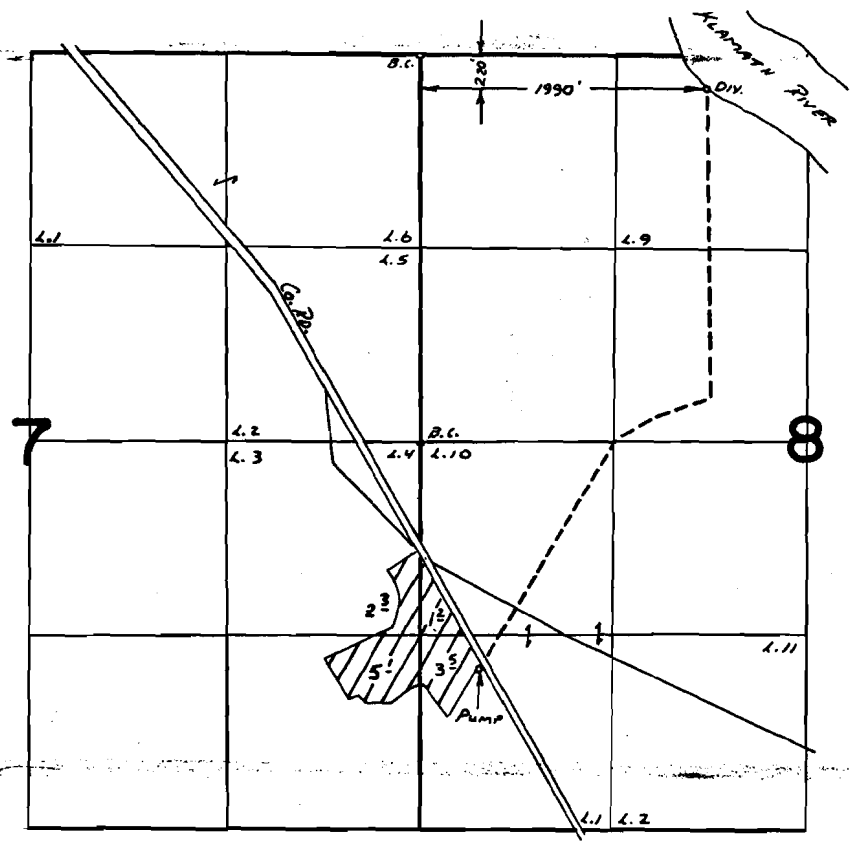

FINAL PROOF SURVEY UNDER

Application No. 45637. Permit No. 34034.
IN NAME OF

JAMES O. & NEDRA M. HOPKINS

Surveyed July 14, 1975, by J. E. Gould