


# T.19S. R.1W.W.M.

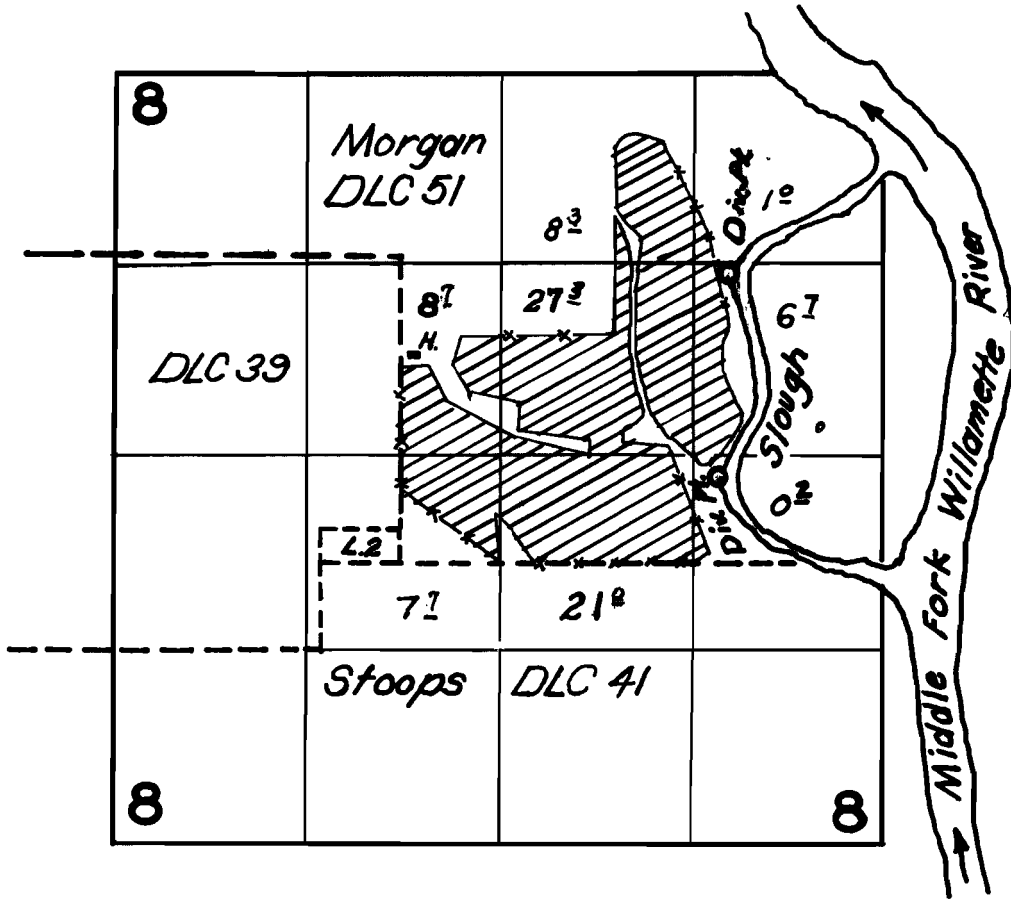

## FINAL PROOF SURVEY UNDER

Application No. 31970 Permit No. 25270  
IN NAME OF

Edgar E. Soultz

Surveyed 26 April 1962, by Carl R. Baker