


T.15S.R.4W.W.M.

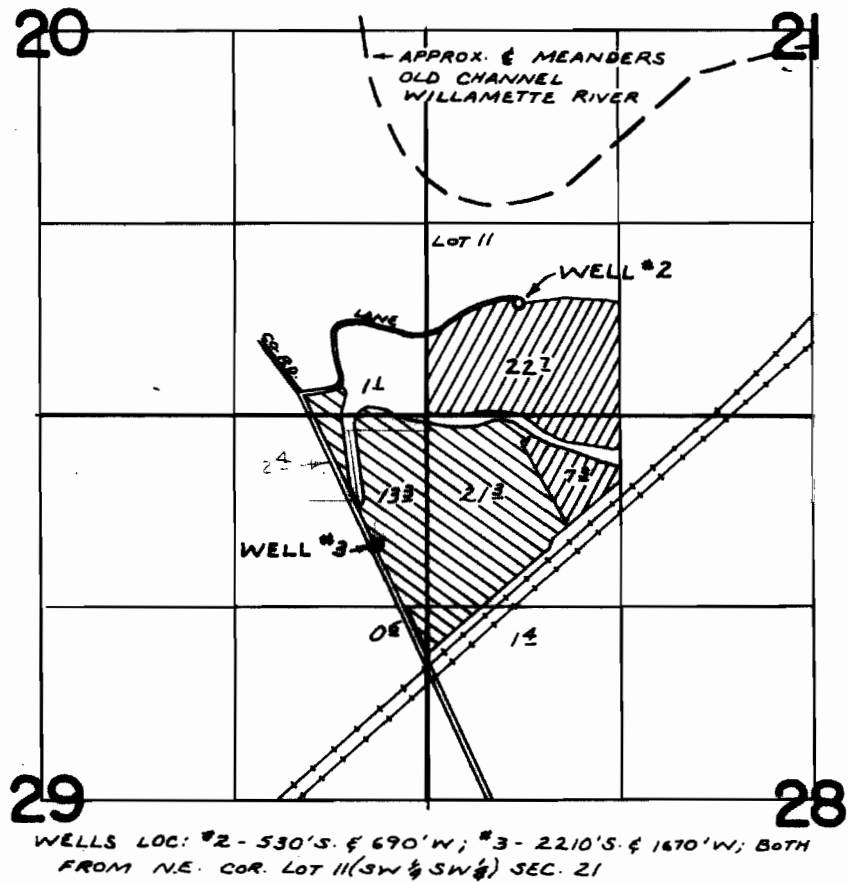

FINAL PROOF SURVEY UNDER

WALLACE E. AYRES

Application No. G-4867 Permit No. G-9582
IN NAME OF

Surveyed MAY 28, 1974, by R. MUCKEN