


T.18 S. R.6 W. W.M.

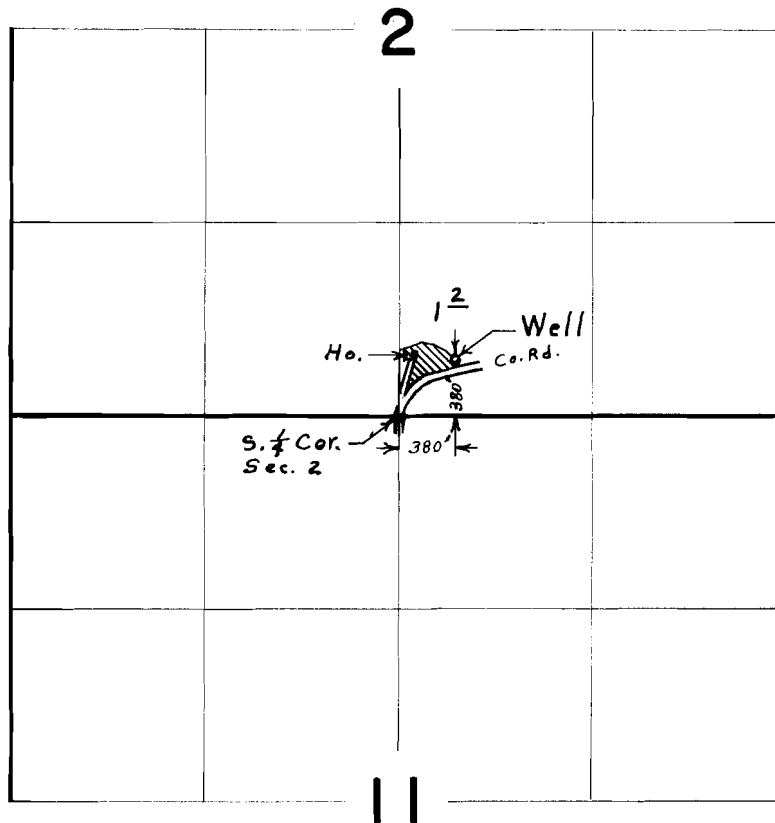

FINAL PROOF SURVEY
UNDER

Application No. G-5415 Permit No. G-5346
IN NAME OF

LA VERN E. CAREY

Surveyed Nov. 5, 1975, by L. E. Gould